

Graham

KANSAS

SECTION 5 TOWNSHIP 9 RANGE 24 11


WELL NO. #2 Keith "B"

COMPANY H. Kaiser & Francis O & G

NORTH

WEST

EAST

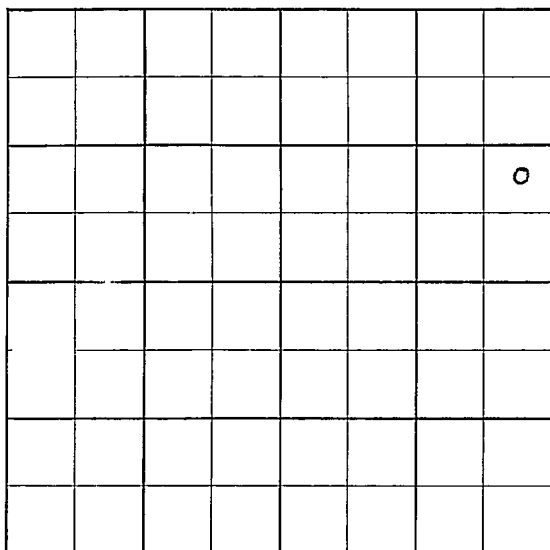

SOUTH

Graham

KANSAS

SEC.	TWP.	R.
5	9	24W

WELL NO.

#2 Keith "B"

FARM

COMPANY

H. Kaiser & Francis O & G

CONTRACTOR

Terrell

NW Holley

Ft. from N. Line


1160'

Ft. from S. Line

Ft. from E. Line

Ft. from W. Line

NE SE NE

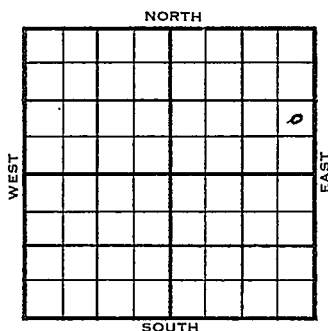

1955

ELEVATION

2483'

REPORT

11/9

Comm 11-5-55

8" @ 255/125

Drlg 1815

12-14

DST 3965-86 op 1 hr. rec. 460' free oil

90' ho&gem, 610/15"

5 1/2" @ 4038

CO 20/ 3969-74

B/ 1 boph, 1500 A,

S/ 23 boph

Comp. 240 bopd

H. 3782

Tr. 3808

L. 3820

TD 4040'

COMPLETED

County Graham

Elev. _____

Sec. 5Twp. 9Rge. 21W

Company H. Kaiser & Francis O & GFarmName Keith "B"No. 2

TOPS

DEPTH

LOG

DATUM

Loc. in Sec. _____

Anh. _____

Tp. _____

H. _____

Tr. _____

Dg. _____

Bl. _____

L. _____

K.C. _____

B.K.C. _____

Ce. _____

C. _____

M. _____

M. _____

K. _____

Mz. _____

Mo. _____

V. _____

S. _____

S. _____

A. _____

R. _____

P.C. _____

G. _____

T.D. _____

NE SE NE

1160' SL

Geol. _____

Contr. _____

Terrell

Pool

NN Holley

NOV 9 55

FIRST REPORT

Date Comm. 11-5-55

8" @ 255/125 drlg. 1815

Co.

Lse.

L No.

Sec.

T.

R.

County Graham Elev. 2483
 Sec. 5 Twp. 9 Rge. 24W
 Company H. Kaiser & Francis O & G
 Farm Name Keith "B" No. 2

TOPS	DEPTH	LOG	DATUM	Loc. in Sec.
Anh.				NE SE NE
Tr.				
H.	<u>3782</u>		<u>1299</u>	
Tr.	<u>3808</u>		<u>1325</u>	1160' SL
Dg.				
BL.				
L.	<u>3820</u>		<u>1337</u>	
K.C.				Geol.
B.K.C.				Contr.
Ce.				
C.				Terrell
M.				
M.				Pool
K.				NW 1/4
Mz.				
Mq.				
V.				
S.				
S.				
A.				
R.				
Pe.				
G.				
TD.	<u>4040</u>			COMPLETE

Date Comm. 11-5-55 DEC 14 1955
 8" @ 255/125 DST 3965-86 open 1 hr.

rec. 460' free oil 90' ho & gcm

610/15" 5 1/2" @ 4038 CO 20/ 3969-74

B/ 1 boph 1500 A S/ 23 boph

Comp. 240 bopd