

SECTION 5 TOWNSHIP 9S RANGE 24W

WELL NO. #4-Waite

COMPANY Empire Drlg.

NW SW NW

NORTH

5

0							

WEST

EAST

SOUTH

Graham

KANSAS


SEC. 5	TWP. 9 S	R. 24 W
-----------	-------------	------------

WELL NO. # 4 Waite FARM

COMPANY Empire Drlg.

CONTRACTOR Co. tools

_____ FT. FROM N. LINE
 _____ FT. FROM S. LINE
 _____ FT. FROM E. LINE
 _____ FT. FROM W. LINE

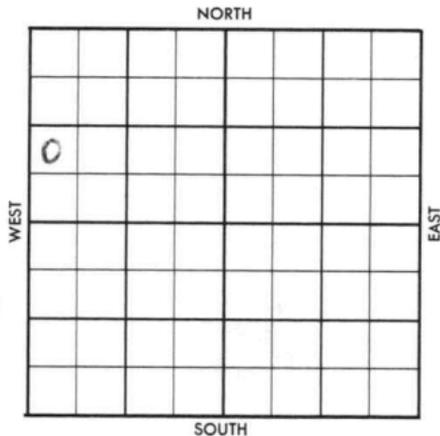

NW SW NW

\$BX-1/4 Mile

1957	ELEVATION 2482' KB	REPORT
------	-----------------------	--------

7/24

Comm. 7-18-57
 8" @ 197/115
 Drlg. 3002'
 Anhy 2176'

(FR Tkt)

FBI 25
.M.M

County Graham Elev. 2482 KB
 Sec. 5 Twp. 9 Rgs. 24W
 Company Empire Drlg.
 Farm Name Waite No. 1

TOPS	DEPTH	LOG	DATUM
Anh.	2176		
Tp.			
H.			
Tr.			
Dg.			
Bl.			
L.			
K.C.			
B.K.C.			
Ce.			
C.			
M.			
M.			
K.			
Mz.			
Me.			
V.			
S.			
S.			
A.			
R.			
PE.			
G.			
T.D.			

Loc. in Sec. NW SW NW

Geol. _____
 Contr. _____
 Co. tools _____
 Pool HOLLY

FIRST REPORT
 1/4 JUL 24 '57
 4 mile

SDX

Date Comm. 7-18-57
8" @ 197/115 drlg. 3002

~~5~~

Co.
Lse.
No.
Sec.
T.
R.

2479 DE

County Graham Elev. 2482 KB
 Sec. 5 Twp. 9 Rge. 24W
 Company Empire Drlg.
 Farm Name Waite No. 4

Co.

	DEPTH	LOG	DATUM
	2175		
H.	3767		
Tr.	3797		
Dg.			
Bl.			
L.	3808		
K.C.			
B.K.C.			
Ce.			
C.			
M.			
M.			
K.			
Mz.			
Me.			
V.			
S.			
S.			
A.			
R.			
Pe.			
G.			
I.D.	4007		

Loc. in Sec. NW SW NW
 Geol. _____
 Contr. _____
 Co. tools _____
 Pool _____

Use.

COMPLETE
 AUG 21 '57
 4 mile

No.

Date Comm. 7-18-57
8" @ 197/115 drlg. 3002

Sec.

3827-40 1hr 75' WM + Tr. oil
BHP 1305/20 DST 3950-71
1hr 60' HOCM BHP 460/30
5 1/2 3999/ WOC AUG 9 '57 CO 4007
2 B0 + 1 BW no time grav 32°
PB 3990 24/3957-63 B 20 Goph
3 28 Boph no/w 4 hrs 500'
O.B. Pop AUG 14 '57 AUG 21 '57
 Phy. Pol. 215 N.K.
 61 41 LON-

T.

R.

3957-63