


Section 5 Township 9 Range 26 W

Well No. #1, Leo Morgan

Company Royer and Farris

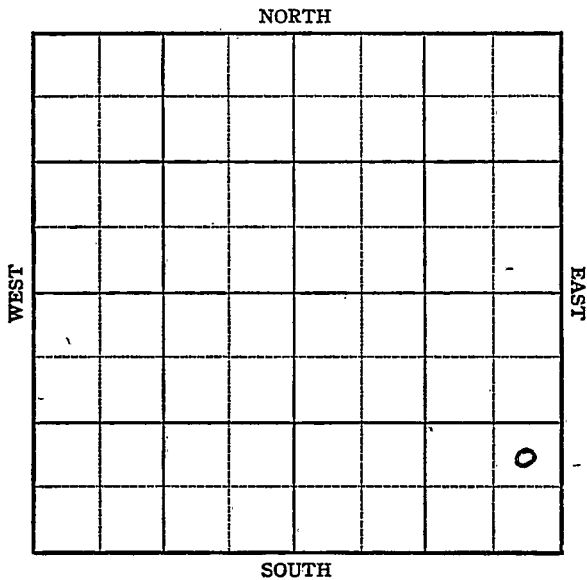

KANSAS

Sheridan County

Sec. 5 Twp. 9 R. 26W

Well No. 1 Leo Morgan Farm

Royer & Farris Company


Wildcat

_____ Ft. from N. Line

990 Ft. from S. Line

330 Ft. from E. Line

_____ Ft. from W. Line

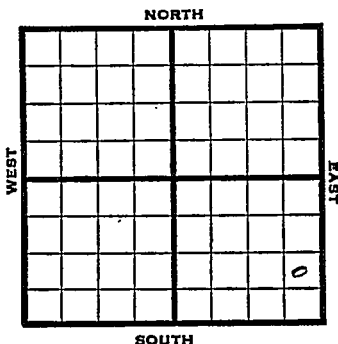

NE SE SE

1947

Elev. 2617

REPORT

1/22

10" @ 245'

Drlg 2560'

1/29

Lans 3763

BKC 3985

TD 4008'

3763
2617
1146

ABANDONED

KANSAS
Kansas

Map No. 67 Sec. 5 Twp. 9 R. 26W

Well No. 1 Leo Morgan

Royer & Farris Company

FIRST REPORT Contractor

NE SE SE

SECTION PLAT

_____ Ft. from N. Line
990 Ft. from S. Line
330 Ft. from E. Line
_____ Ft. from W. Line

Sheridan County

Location _____

Rig up _____

Drilling and Remarks:

10" @ 245
drlg. 2560

RECORD

Cased _____ in., _____ ft.
Sand _____
Gas _____
Oil _____
Total Depth _____

PRODUCTION

1st 24 hrs. Nat. _____
1st 24 hrs. after shot _____
Gas _____ Cu. Ft.
Dry Hole _____
Abandoned _____

Date

JAN 22 1947 19

S. J. LEWIS Scout

