


Books Kansas

DX 78-1

Section 6 Township 9 Range 17W

Well No. 1 Garvet

Company Trans -Era & Oil Trading

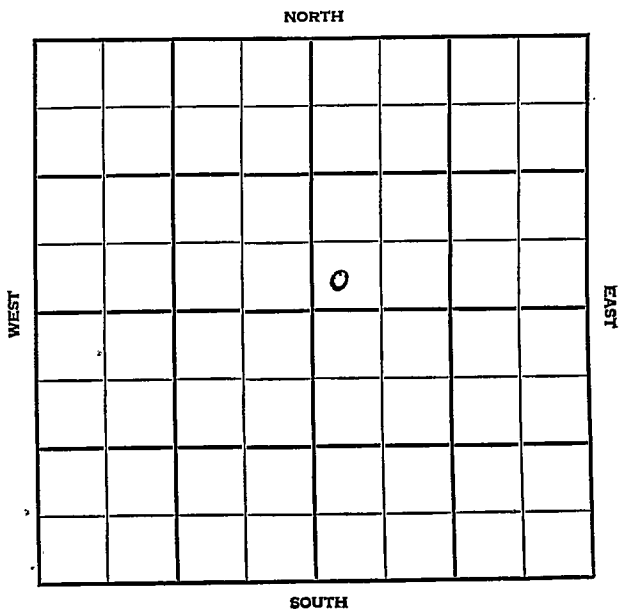

SEC.	TWP.	R.
6	9	17W

WELL NO.

1 Garvet

FARM

COMPANY

Trans-Eta & Oil Trading

CONTRACTOR

Trans-Era Contr.


Dopita Pool

_____ Ft. from N. Line

330 _____ Ft. from S. Line

_____ Ft. from E. Line

330 _____ Ft. from W. Line

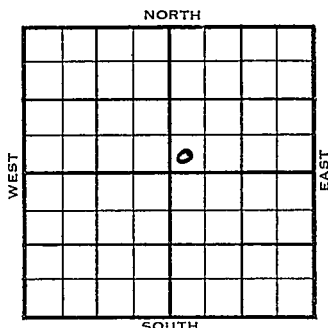


SW SW NE

	ELEVATION	REPORT
1954	1944'	
6/15	Spdg 6-12-54 8" @ 165'	
6/30	Drlg. 1040' Drlg. 1040'	
7/7	Drlg. 1040'	
8/4	Spud 6-12-54 Oil Well TD 3362' 8" @ 165' Anhy 1260', Heeb 3057', Tor 3078', Lans 3097' DST 3178-3200', opn 1 1/3 hr., rec. 8' mud DST 3248-80', opn 1 1/3 hr., rec. 9' mud Arb. 3355' TD 3357' 5" @ 3356' CO to 3357' 1 1/2 boph DD 3359 500A 3 boph DD 3362 500A S/16 bo 1 hr., S/18 bo 2nd hr. omp. 312 bopd	
COMPLETED		

J. G. McGEHEE

County _____ Rocks _____ State **Kansas**
 Sec. **6** (Blk.) **9** (Sur.) **17W** Map No. _____
 Operator **Trans-Era & Oil Trading**
 Well No. **1** Farm **Garvet**
 Elev. **1944** Location **SW SW NE**

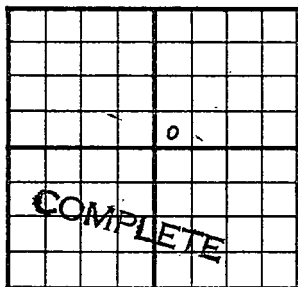

330 Ft. From S Line NE
330 Ft. From W Line Quarter
 Ist. Report _____
 Completion **AUG 4 1954**
 Remarks **Dopita Pool**
Trans-Era - Contr.
 Spudding Date **6-12-54**

Drlg. Data **Oilwell TD 3362**
8" @ 165 Anhy 1260 Heeb. 3057
Tor. 3078 Lans. 3097 DST 3178-3200
open 1 1/3 hr. Rec. 8' mud DST 3248-80
open 1 1/3 hr. Rec. 9' mud Arb. 3355
TD 3357 5" @ 3356 CO to 3357
1 1/2 boph DD 3359 500 A 3 boph
DD 3362 500 A S/ 16 bo 1 hr.
S/ 18 bo 2nd hr. Comp. 312 bopd

J. G. McGEHEE