


Section 6 Township 9 Range 17-W

Well No. #1 Moos

Company George Vance et al.

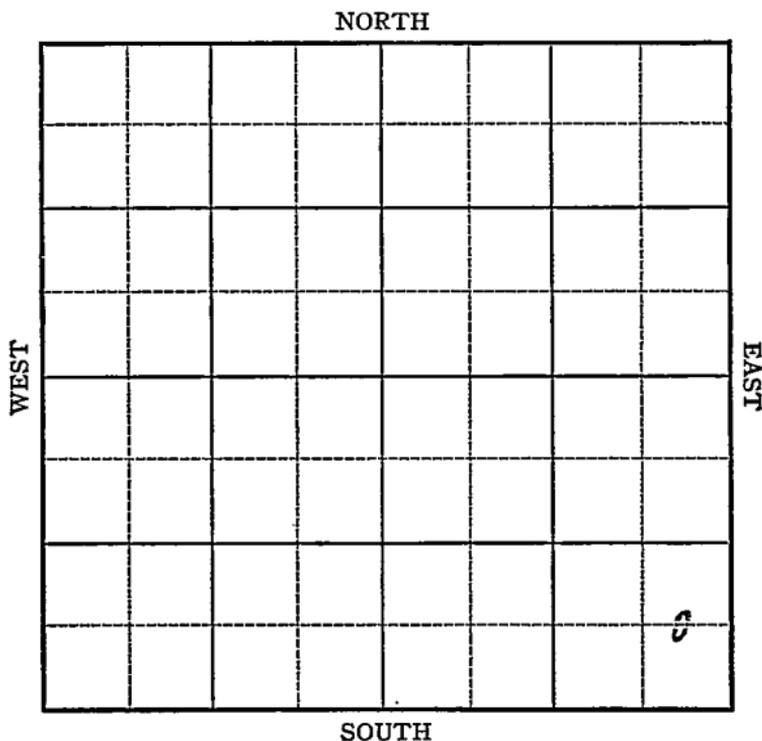

Sec: 6 Twp. 9 R. 17-W

Well No. #1 Moos Farm

George Vance et al Company

(Wildcat)


_____ Ft. from N. Line

660 Ft. from S. Line

330 Ft. from E. Line

_____ Ft. from W. Line

Elev. 1965

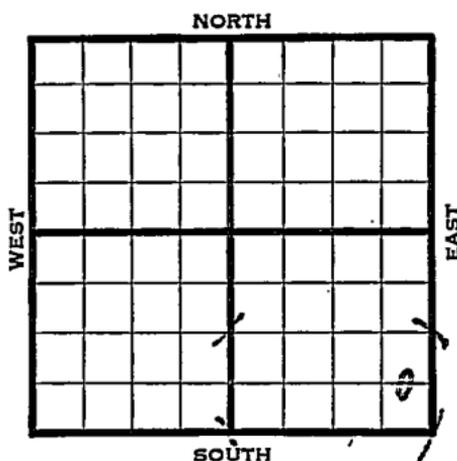

1941	REPORT
11/5	Location
11/13	8" - 92' Anhy 1200'
	Drlg. 1809'
11/20	Dodge 3087' Lans. 3114'
	Drlg. 3188'
11/26	S.S.O. 3114-21' B.K.C. 3344'
	Arb. 3390-95' T.D. 5" - 3391'
	RUST.
12/4	T.D. 3406' 100' oil 9 hours.
	500 acid. 500 Butane.
	23 shots 3213-17 $\frac{1}{2}$ ' 4500 acid.
	77 $\frac{1}{2}$ bbls. fluid in 8 hours -
	18 $\frac{1}{2}$ % oil.
12/11	" " " " "
12/18	" " " " "
12/24	" " " " "
12/31	" " " " "
1942	
1/8	" " " " "
1/15	" " " " "
1/22	" " " " "

OVER

1942
1/29

T.D. 3406'

77½ bbls. in 8 hours. 8½% oil.

2/5	"	"	"	"
2/12	"	"	"	"
2/19	"	"	"	"
2/26	"	"	"	"
3/4	"	"	"	"
3/12	"	"	"	"
3/19	"	"	"	"

3/25

Lans. 3114'

Arb. 3390'

5" - 3391'

T.D. 3406'

23 shots 3213-17½'

4500 acid.

Pump 200 oil & 18% water from Lans.

36. Gravity


COMPLETED

Map No. K-67 Sec. 6 Twp. 9 R. 17WWell No. 1 MoosGeorge Vance et al. CompanyFIRST REPORT Contractor

C E L S E S E

 Ft. from N. Line660 Ft. from S. Line330 Ft. from E. Line Ft. from W. Line

SECTION PLAT

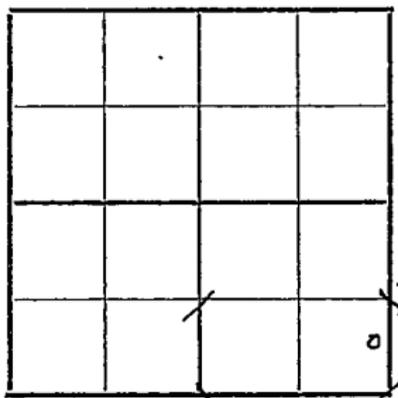

WILDCAT

Location XXRig up

Drilling and Remarks:

RECORD

Cased in., ft.Sand Gas Oil Total Depth

PRODUCTION

1st 24 hrs. Nat. 1st 24 hrs. after shot Gas Cu. Ft.Dry Hole Abandoned

Date

NOV 5 1941 19S. J. LEWIS Scout

Map No. 64 Sec. 6 Twp. 9 R. 17W

Well No. 1 Moos

Geo. Vance et al. Company

COMPLETED

Contractor

C E L S E S E

SECTION PLAT

_____ Ft. from N. Line

660 Ft. from S. Line

330 Ft. from E. Line

_____ Ft. from W. Line

WILD CAT

Location _____

Rig up _____

Drilling and Remarks:

Loss 3114

Ce 43390

5" O 3391

23 shot to 3219 - 17 1/2

4500 acio 6

Pump 200 oil + 18%

Water from Lane.

360 gr

RECORD

Cased _____ in., _____ ft.

Sand _____

Gas _____

Oil _____

Total Depth 3406

PRODUCTION

1st 24 hrs. Nat. _____

1st 24 hrs. after shot _____

Gas _____ Cu. Ft.

Dry Hole _____

Abandoned _____

Date

MAR 25 1942 19

S. J. LEWIS Scout