



Sec. 6 Twp. 9 R. 18-W

Well No. #1 Gick Farm \_\_\_\_\_

B & R Drlg. Company \_\_\_\_\_

B & R Drlg. Contractor \_\_\_\_\_


**East Berry**

\_\_\_\_\_ Ft. from N. Line

330 Ft. from S. Line

990 Ft. from E. Line

\_\_\_\_\_ Ft. from W. Line

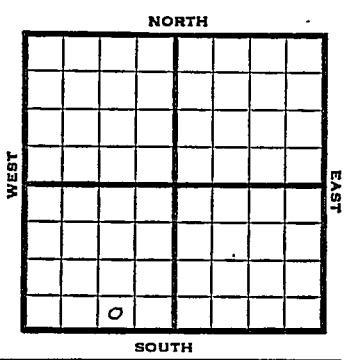

SW SE SW

1950

Elev. 2040' REPORT

11/1

Spud 10-25-50  
8" @ 202  
Drlg 2615

1951  
4/4

Spud 10-25-50  
Oil well TD 3477'  
8" @ 202 Heeb. 3209', Lans. 3255',  
SO 3264-68', 3388-91', 3400-02',  
Arb. 3473-77' TD 5" @ 3472'  
S/ 550' oil 1 hr.  
Comp. 80 BOPD 51% water

**COMPLETED**



