

Well No. 1 Gilbert

Company Harry Gore

Harry Pool
NORTH

[illegible]

KANSAS

Rooks

Sec. 6 Twp. 9 R. 18W ✓

Well No. #1 Gilbert Farm

Harry Gore

Company

Barry Pool


 Ft. from N. Line

330' Ft. from S. Line

 Ft. from E. Line

990' Ft. from W. Line

SE SW SE

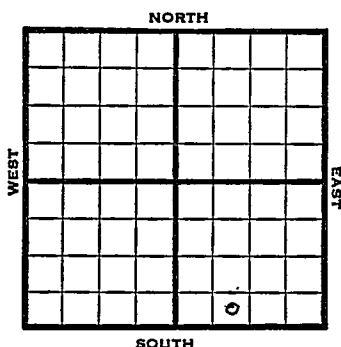

1949

Elev 2050' REPORT

4/27

Location

5/4

RUR

5/10

8" @ 185

Drlg 3130'

5/18

TD 3528'

Lans. 3247'

Arb. 3492'

Aband.

ABANDONED

Kansas

Map No. _____ Sec. 6 Twp. 9 R. 18WWell No. 1 GilbertHarry Gore


Company

FIRST REPORT

Contractor

SE SW SE

SECTION PLAT

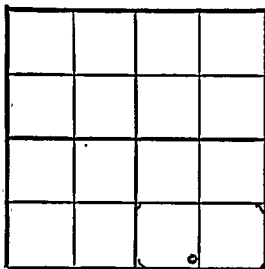

_____ Ft. from N. Line

330 Ft. from S. Line

_____ Ft. from E. Line

990 Ft. from W. Line

Rooks County

Location X

Rig up _____

Drilling and Remarks:

RECORD

Cased _____ in., _____ ft.

Sand _____

Gas _____

Oil _____

Total Depth _____

PRODUCTION

1st 24 hrs. Nat. _____

1st 24 hrs. after shot _____

Gas _____ Cu. Ft.

Dry Hole _____

Abandoned _____

Date

APR 27 1949 19

S. J. LEWIS Scout

Map No. K64 Sec. 6 Twp. 9 R. 18W

Well No. 1 Gilbert

Harry Gore

Company

ABANDONED

Contractor

SE SW SE

E12050
SECTION PLAT

			0

 Ft. from N. Line

330

 Ft. from S. Line

 Ft. from E. Line

990

 Ft. from W. Line

Rooks County

Location

Rig up

Drilling and Remarks:

Loss 3247

Cost 3492.

RECORD

Cased in., ft.

Sand

Gas

Oil

Total Depth 3528

PRODUCTION

1st 24 hrs. Nat.

1st 24 hrs. after shot

Gas Cu. Ft.

Dry Hole

Abandoned

Date

MAY 18 1949

S. J. LEWIS Scout