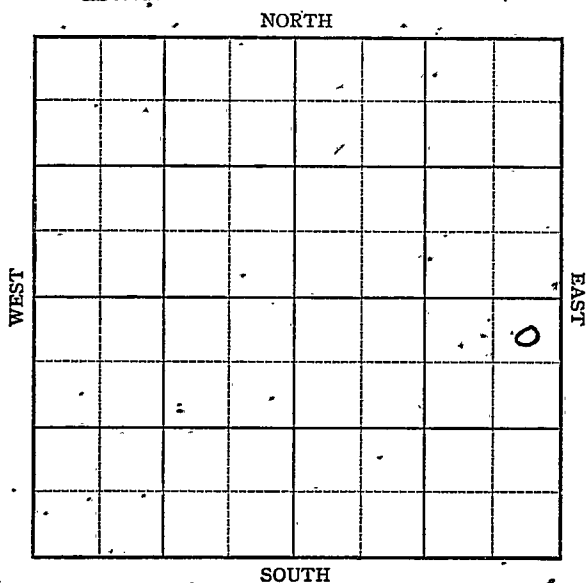



KANSAS

Section 6 Township 9 Range 18-WWell No. #1 GilbertCompany Continental
Paradise

KANSAS

Sec. 6 Twp. 9 R. 18-WWell No. #1 Gilbert FarmContinental CompanyParadise Pool330 Ft. from N. Line Ft. from S. Line330 Ft. from E. Line Ft. from W. Line

NE SE

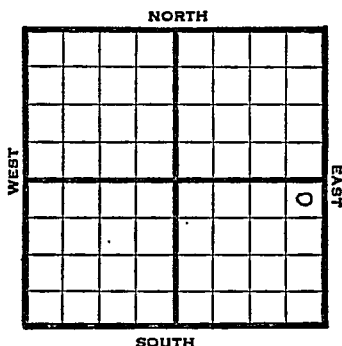

1947 Elev. 2072' REPORT

6/18 Derrick

6/24 10" @ 200'
Drlg 2093'7/1 Lansing 3238'
Arbuckle 3487'-91' TD
5" @ 3489'
RUST7/8 TD 3492'
Bail 4 bbls oil PH7-16 TD 3498
500 Acid
Shot 224 bbls. oil in 8 hrs.

7/22 "

7/29 TD 3498'

8/6 "

8/13 "

8/20 "

8/27 Arbuckle 3487'
5" @ 3489'
500 Acid
Pump 609 Pot
Gr. 220
Total Depth 3498'**COMPLETED**

Map No. _____ Sec. 6 Twp. 9 R. 18W

Well No. 1 Gilbert

Continental Company

FIRST REPORT Contractor

NE SE


SECTION PLAT

330 Ft. from N. Line

_____ Ft. from S. Line

330 Ft. from E. Line

_____ Ft. from W. Line

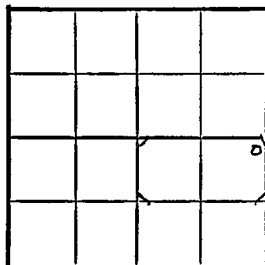

Rooks County

Location _____

Rig up _____

Drilling and Remarks:

Derrick

RECORD

Cased _____ in., _____ ft.

Sand _____

Gas _____

Oil _____

Total Depth _____

PRODUCTION

1st 24 hrs. Nat. _____

1st 24 hrs. after shot _____

Gas _____ Cu. Ft.

Dry Hole _____

Abandoned _____

Date

JUN 1 8 1947 19 S. J. LEWIS Scout

Map No. 64 Sec. 6 Twp. 9 R. 18W

Well No. 1 Gilbert

Continental Company

COMPLETE

Contractor

NE SE


E 12072
SECTION PLAT

330 Ft. from N. Line

_____ Ft. from S. Line

330 Ft. from E. Line

_____ Ft. from W. Line

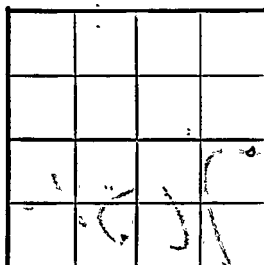

Rooks County

Location _____

Rig up _____

Drilling and Remarks:

Cor 43487
5" @ 3489
500 acid

Only 609 ft

22 3/4

RECORD

Cased _____ in., _____ ft.

Sand _____

Gas _____

Oil _____

Total Depth 3498

PRODUCTION

1st 24 hrs. Nat. _____

1st 24 hrs. after shot _____

Gas _____ Cu. Ft.

Dry Hole _____

Abandoned _____

Date

AUG 27 1947

19

S. J. LEWIS

Scout