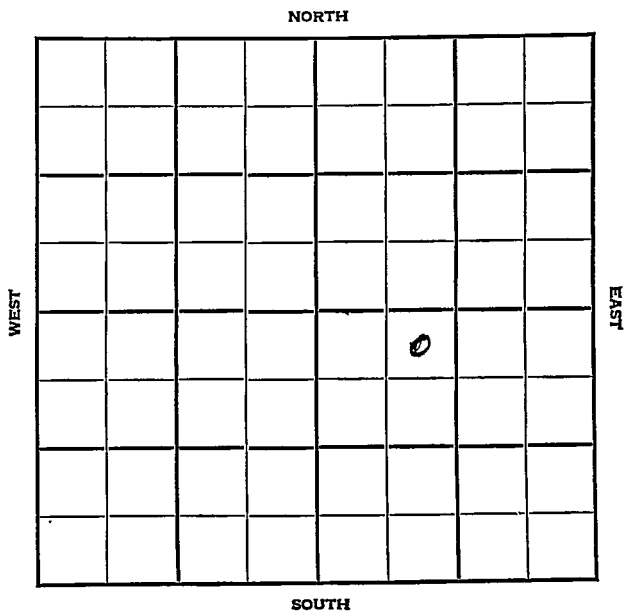


Section 6 Township 9 Range 18WWell No. #2 GilbertCompany Continental

KANSAS

Rooks

Sec. 6 Twp. 9 R. 18-W

Well No. #2 Gilbert Farm

Continental Company

Gick Pool


330' Ft. from N. Line

Ft. from S. Line

Ft. from E. Line

990' Ft. from W. Line

NE NW SE

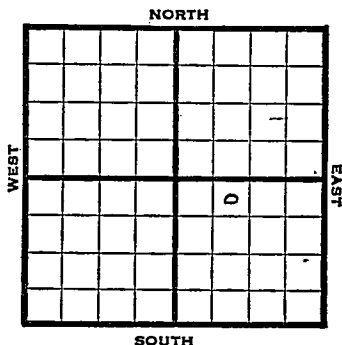

1948

Elv. 2063' REPORT

1/7 Derrick

1/14 RUR

1/21 Drlg. 2876'

2/26 Arbuckle 3493-95'

TD 3495'

6" @ 3493'

RUST

2/4 TD 3499'

Bail 3 gals. oil 1 hr.

2/11 TD 3535'

2500' water PB

2/18 TD 3380

96. shots 3330-62

48 shots 3286-96 swb 81 bbls oil / 96

Water 48 hrs.

2/24 Arb. 3493'

6" @ 3493'

Lans. 3245' Perf. Lans. 2000 acid

Pump 79 oil / 50% W pot.

39.0 Gr.

TD 3535'

Comp.

COMPLETED

Map No. _____ Sec. 6 Twp. 9 R. 18W

Well No. 2 Gilbert

Continental

Company

FIRST REPORT

Contractor

NE NW SE

SECTION PLAT

330 Ft. from N. Line

_____ Ft. from S. Line

_____ Ft. from E. Line

990 Ft. from W. Line

		6	

Rooks County

Location _____

Rig up _____

Drilling and Remarks:

Derrick

RECORD

Cased _____ in., _____ ft.

Sand _____

Gas _____

Oil _____

Total Depth _____

PRODUCTION

1st 24 hrs. Nat. _____

1st 24 hrs. after shot _____

Gas _____ Cu. Ft.

Dry Hole _____

Abandoned _____

Date

JAN 7 1948 19 S. J. LEWIS Scout

Map No. 64 Sec. 6 Twp. 9 R. 18W

Well No. 2 Gilbert

Continental Company

COMPLETE

Contractor

NE NW SE

E12063


SECTION PLAT

330 Ft. from N. Line

_____ Ft. from S. Line

_____ Ft. from E. Line

990 Ft. from W. Line

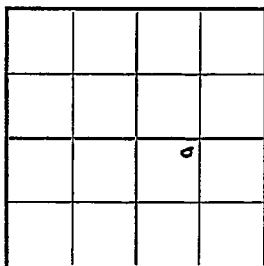

Rooks County

Location _____

Rig up _____

Drilling and Remarks:

Ac 83428

6" @ 3498

Loss 3245

Prof. Loss.

2000 ac. oil

Pump 77 oil + 50% oil

292

Date

292

RECORD

Cased _____ in., _____ ft.

Sand _____

Gas _____

Oil ☒ _____

Total Depth 3535

PRODUCTION

1st 24 hrs. Nat. _____

1st 24 hrs. after shot _____

Gas _____ Cu. Ft.

Dry Hole _____

Abandoned _____

FEB 25 1948 19

S. J. LEWIS Scout