


Section 6 Township 9 Range 18WWell No. 1 ThompsonCompany Continental

Barry

NORTH

WEST

EAST

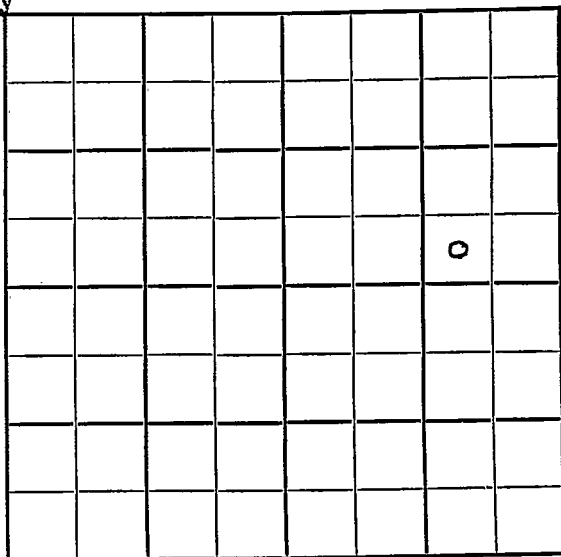

SOUTH

KANSAS

Rooks

Sec. 6 Twp. 9 R. 18W

Well No. #1 Thompson Farm
Continental Company

Barry Pool

Ft. from N. Line

330


Ft. from S. Line

990

Ft. from E. Line

Ft. from W. Line

SW SE NE

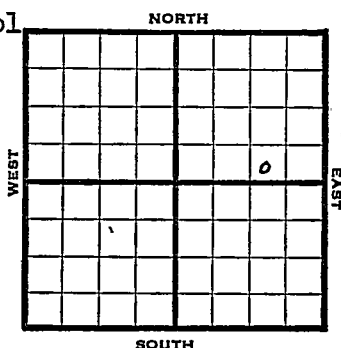

1947

Elev. 2068' REPORT

11/5

Location

11/12

Derrick.

11/19

10" @ 205'

WOC

11/25

Drilg. 2727'

12/3

Lansing 3240'

Arbuckle 3489'

TD 3497'

6" @ 3490'

RUST

12/10

TD 3499' - 500 acid

Swb. 60 bbls. oil ph 2 hrs.

12/17

Arbuckle 3489'

6" @ 3490

500 Acid

Echo Pot 2197

TD 3499

Gravity 28.4

COMPLETED

3489
2068
1421

Map No. _____ Sec. 6 Twp. 9 R. 18W

Well No. 1 Thompson

Continental Company

FIRST REPORT Contractor

SW SE NE

SECTION PLAT

_____ Ft. from N. Line


330

_____ Ft. from S. Line

990

_____ Ft. from E. Line

_____ Ft. from W. Line

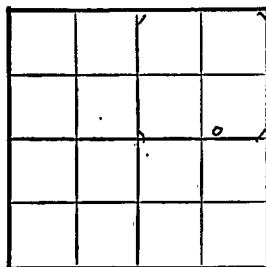

Rooks County

Location X

Rig up _____

Drilling and Remarks:

RECORD

Cased _____ in., _____ ft.

Sand _____

Gas _____

Oil _____

Total Depth 1000

PRODUCTION

1st 24 hrs. Nat. _____

1st 24 hrs. after shot _____

Gas _____ Cu. Ft.

Dry Hole _____

Abandoned _____

Date

NOV 5 1947 19 S. J. LEWIS Scout

Map No. 64 Sec. 6 Twp. 9 R. 18W

Well No. 1 Thompson

Continental Company

COMPLETE Contractor

SW SE NE

E12068
SECTION PLAT

 Ft. from N. Line

330 Ft. from S. Line

990 Ft. from E. Line

 Ft. from W. Line

			0

Rooks County

Location

Rig up

Drilling and Remarks:

Ar 43489

6" @ 9490

5000 acs

Echd R 42197

28 3/4

RECORD

Cased in., ft.

Sand

Gas

Oil

Total Depth 3489

PRODUCTION

1st 24 hrs. Nat.

1st 24 hrs. after shot

Gas Cu. Ft.

Dry Hole

Abandoned

Date

DEC 17 1947

19

S. J. LEWIS

Scout