

KANSAS

Rooks



Sec. 6 Twp. 9 R. 18W

Well No. #3 Thompson Farm

Continental Company

Barry Pool


990' Ft. from N. Line

_____ Ft. from S. Line

_____ Ft. from E. Line

330' Ft. from W. Line

SW NW NE

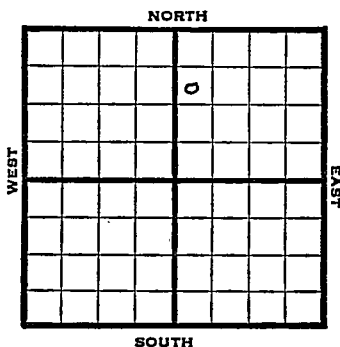

1948 Elev. 2052' REPORT

- 3/3 Location
- 3/10 "
- 3/17 Derrick.
- 3/24 "
- 3/31 "
- 4/7 "
- 4/14 10" @ 204'
Drlg. 1000'
- 4/21 Drlg. 2735'
- 4/28 Arbuckle 3477'
TD 3484'
6" @ 3478'
RUST
- 5/5 "
- 5/12 1000 Acid swb 106 bbls oil
PH, 3 hrs.
- 5/19 Arbuckle 3477'
6" @ 3478'
Acid 7000
Depth Pot. 3000 oil
Gr. 30°
TD 3484'

COMPLETED

Map No. _____ Sec. 6 Twp. 9 R. 18W

Well No. 3 Thompson

Continental Company

FIRST REPORT

Contractor

SW NW NE

SECTION PLAT

990 Ft. from N. Line

_____ Ft. from S. Line

_____ Ft. from E. Line

330 Ft. from W. Line

Rooks County

Location X

Rig up _____

Drilling and Remarks:

RECORD

Cased _____ in., _____ ft.

Sand _____

Gas _____

Oil _____

Total Depth _____

PRODUCTION

1st 24 hrs. Nat. _____

1st 24 hrs. after shot _____

Gas _____ Cu. Ft.

Dry Hole _____

Abandoned _____

Date

MAR 3 1948 19

S. J. LEWIS Scout

