


Section 6 Township 9 Range 18-W

Well No. #1 Thompson

Company Continental

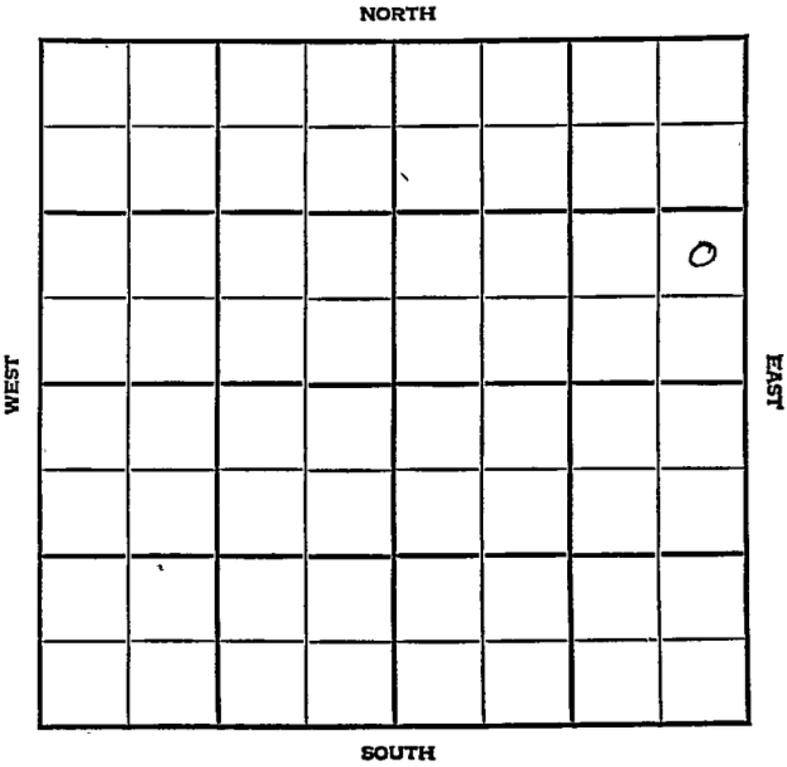

Sec. 6 Twp. 9 R. 18W

Well No. #4 Thompson Farm

Continental Company

Barry Pool


 Ft. from N. Line

990' Ft. from S. Line

330' Ft. from E. Line

 Ft. from W. Line

NE SE NE

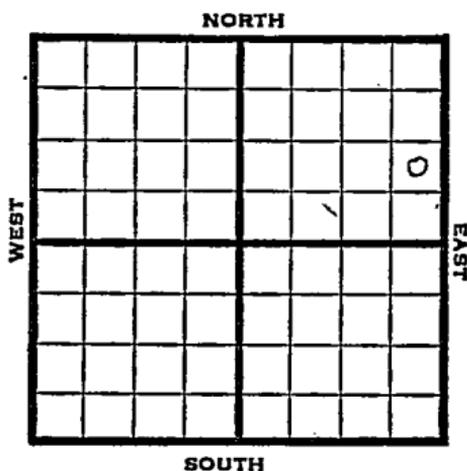

1948 Elev. 2072' REPORT

6/23	Location
6/29	Derrick
7/8	"
8/14	"
7/21	10" @ 204 WOC
7/28	Drilg-3108'
8/4	Lansing 3245' Arbuckle 3492-96' TD 3496' 6" @ 3492'
8/11	Arbuckle 3492' 6" @ 3492' TD 3501' 500 acid Depth Pot. 2160 oil & 560 W Gr. 27°

COMPLETED

Map No. _____ Sec. 6 Twp. 9 R. 18W

Well No. 4 Thompson

Continental Company

FIRST REPORT

Contractor

NE SE NE

SECTION PLAT

_____ Ft. from N. Line

990 Ft. from S. Line

330 Ft. from E. Line

_____ Ft. from W. Line

			o

Rooks County

RECORD

Location X

Rig up _____

Drilling and Remarks: _____

Cased _____ in., _____ ft.

Sand _____

Gas _____

Oil _____

Total Depth _____

PRODUCTION

1st 24 hrs. Nat. _____

1st 24 hrs. after shot _____

Gas _____ Cu. Ft.

Dry Hole _____

Abandoned _____

Date

JUN 23 1948 19

S. J. LEWIS Scout

Rooks County Kansas State

Map No. 64 Sec. 6 Twp. 9 R. 18W

Well No. 4 Thompson

Continental Company

COMPLETE

Contractor

NE SE NE

E12072
SECTION PLAT

 Ft. from N. Line

990 Ft. from S. Line

330 Ft. from E. Line

 Ft. from W. Line

							0

Barry Pool

Remarks:

Cr # 2492

6" @ 2492

7178501

500 and

Depth to 2160' at 7560' W

27' br



Date
AUG 11 1948

Scout
S. J. LEWIS