


KANSAS

Books

Section 6 Township 9 Range 18W

Well No. #2 Thompson

Company Continental

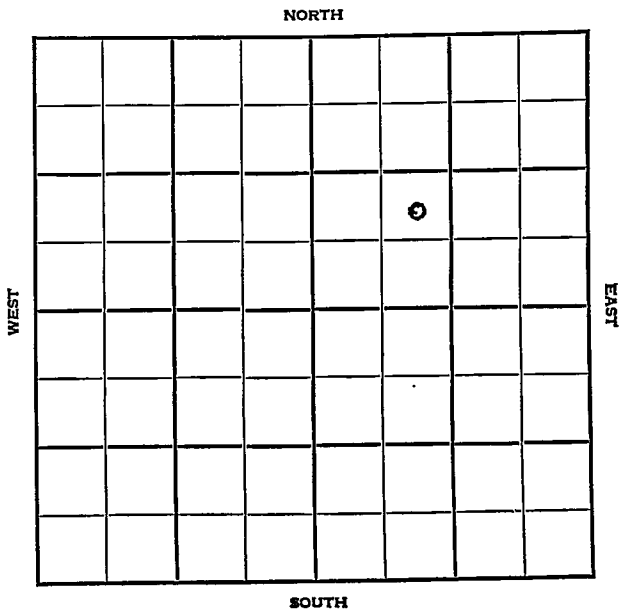

KANSAS

Rooks



Sec. 6 Twp. 9 R. 18W

Well No. #2 Thompson Farm

Continental

Company

Barry


 Ft. from N. Line

990 Ft. from S. Line

 Ft. from E. Line

990 Ft. from W. Line

NE SW NE

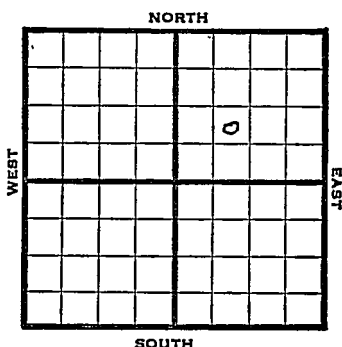

1948

Elv. 2058' REPORT

1/28 8" @ 205'
WOC

2/4 Drlg. 2728'

2/11 Arbuckle 3479'
TD 3483'
6" @ 3480'
RUST

2/18 "

2/24 Lans. 3329'
Arb. 3479'
6" @ 3480'
Depth Pot 2374'
Gr. 28.0
TD 3490'

COMPLETED

Map No. _____ Sec. 6 Twp. 9 R. 18W

Well No. 2 Thompson

Continental Company

FIRST REPORT Contractor

NE SW NE

SECTION PLAT

_____ Ft. from N. Line

990 Ft. from S. Line

_____ Ft. from E. Line

990 Ft. from W. Line

		o	

Rooks County

Location _____

Rig up _____

Drilling and Remarks:

8" @ 205 WOC

RECORD

Cased _____ in., _____ ft.

Sand _____

Gas _____

Oil _____

Total Depth _____

PRODUCTION

1st 24 hrs. Nat. _____

1st 24 hrs. after shot _____

Gas _____ Cu. Ft.

Dry Hole _____

Abandoned _____

Date

JAN 28 1948 19

S. J. LEWIS

Scout

Map No. 64 Sec. 6 Twp. 9 R. 18W

Well No. 2 Thompson

Continental Company

COMPLETE

Contractor

NE SW NE

E 12058
SECTION PLAT

 Ft. from N. Line

990 Ft. from S. Line

 Ft. from E. Line

990 Ft. from W. Line

		0	

Rooks County

Location

Rig up

Drilling and Remarks:

Lane 3329

Cut 3499

6 " @ 3480

Depth 2874

2874

2874

RECORD

Cased in., ft.

Sand

Gas

Oil ✓

Total Depth 3480

PRODUCTION

1st 24 hrs. Nat.

1st 24 hrs. after shot

Gas Cu. Ft.

Dry Hole

Abandoned

Date

FEB 25 1948

19

S. J. LEWIS Scout