


Section 6 Township 9- Range 18-W  
Well No. #5 Thompson  
Company Continental

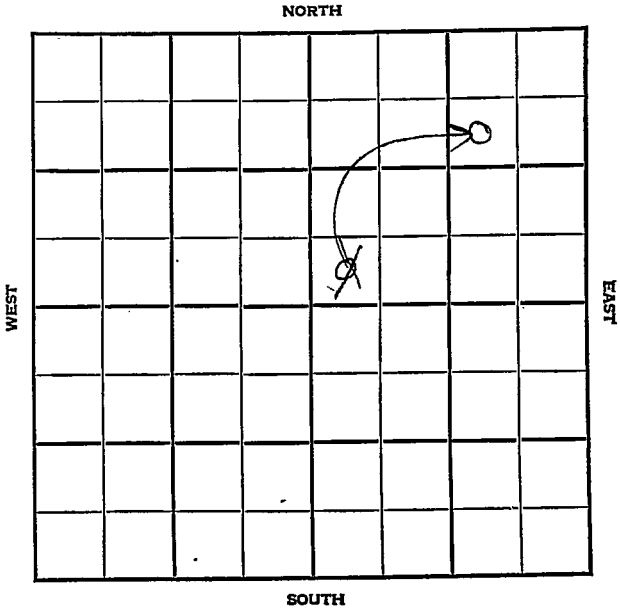

**KANSAS**

Rooks



Sec. 6 Twp. 9 R. 18W

Well No. #5 Thompson Farm \_\_\_\_\_

Continental

Company \_\_\_\_\_

Barry Pool


990' Ft. from N. Line

~~330'~~ Ft. from S. Line

990' Ft. from E. Line

~~330'~~ Ft. from W. Line

SW NE NE

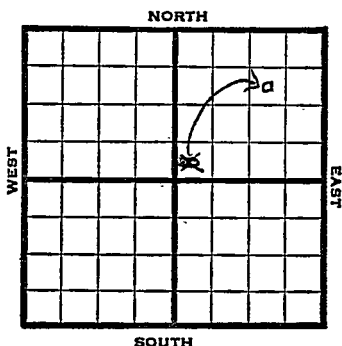

1948

Eli 2064'

REPORT

6/30	Location
7/8	"
7/14	"
7/21	Location
7/28	"
8/4	10" @ 204'
	Drlg. 375'
8/11	Drlg 3275'
8/18	Arb. 3487'
	6" @ 3488'
	TD 3494'
	Sw 5 bbls oil PH
8/25	Arbuckle 3487'
	6" @ 3488'
	TD 3496'
	500 acid
	Depth Pot 3000 oil
	27° Gr.
	Comp

**COMPLETED**

Map No. \_\_\_\_\_ Sec. 6 Twp. 9 R. 18W

Well No. 5 Thompson

Continental Company

# FIRST REPORT

Contractor

SW NE

## SECTION PLAT

		o	

\_\_\_\_\_ Ft. from N. Line

330 Ft. from S. Line

\_\_\_\_\_ Ft. from E. Line

330 Ft. from W. Line

Rooks County

Location X

Rig up \_\_\_\_\_

Drilling and Remarks:

## RECORD

Cased \_\_\_\_\_ in., \_\_\_\_\_ ft.

Sand \_\_\_\_\_

Gas \_\_\_\_\_

Oil \_\_\_\_\_

Total Depth \_\_\_\_\_

## PRODUCTION

1st 24 hrs. Nat. \_\_\_\_\_

1st 24 hrs. after shot \_\_\_\_\_

Gas \_\_\_\_\_ Cu. Ft.

Dry Hole \_\_\_\_\_

Abandoned \_\_\_\_\_

Date

JUN 30 1948 19

S. J. LEWIS Scout



