

KANSAS Rooks ✓
18W

Sec. 6 Twp. 9 R. 18W

Well No. 6 Thompson Farm
Continental Company
Barry Pool


330 Ft. from N. Line

 Ft. from S. Line

 Ft. from E. Line

990 Ft. from W. Line

NE NW NE

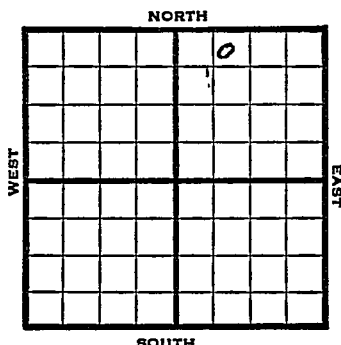

1948	Elev. 2055' REPORT
11/17	Location
11/23	"
11/30	"
12/8	RUR
12/15	10" @ 214' D rlg 2680'
12/22	Lens 3244' Arb 3510' TD 3515' ABANDONED

Map No. _____ Sec. 6 Twp. 9 R. 18W

Well No. 6 Thompson

Continental Company

FIRST REPORT

Contractor _____

NE NW NE

SECTION PLAT

330 Ft. from N. Line

_____ Ft. from S. Line

_____ Ft. from E. Line

990 Ft. from W. Line

		6	

Rooks County

Location X

Rig up _____

Drilling and Remarks:

RECORD

Cased _____ in., _____ ft.

Sand _____

Gas _____

Oil _____

Total Depth _____

PRODUCTION

1st 24 hrs. Nat. _____

1st 24 hrs. after shot _____

Gas _____ Cu. Ft.

Dry Hole _____

Abandoned _____

Date

NOV 17 1948 19

S. J. LEWIS

Scout

Map No. 64 Sec. 6 Twp. 9 R. 18W

Well No. 6 Thompson

Continental Company

ABANDONED Contractor

NE NW NE

B12055
SECTION PLAT

330 Ft. from N. Line

 Ft. from S. Line

 Ft. from E. Line

990 Ft. from W. Line

		0	

Rooks County

Location

Rig up

Drilling and Remarks:

Loss 3244

Cost 3510

RECORD

Cased in., ft.

Sand

Gas

Oil

Total Depth 3515

PRODUCTION

1st 24 hrs. Nat.

1st 24 hrs. after shot

Gas Cu. Ft.

Dry Hole

Abandoned

Date

DEC 22 1948

19

S. J. LEWIS

Scout