


O.W.W.C.

Section 6 Township 9 Range 18W

Well No. #7 Thompson

Company Continental Oil

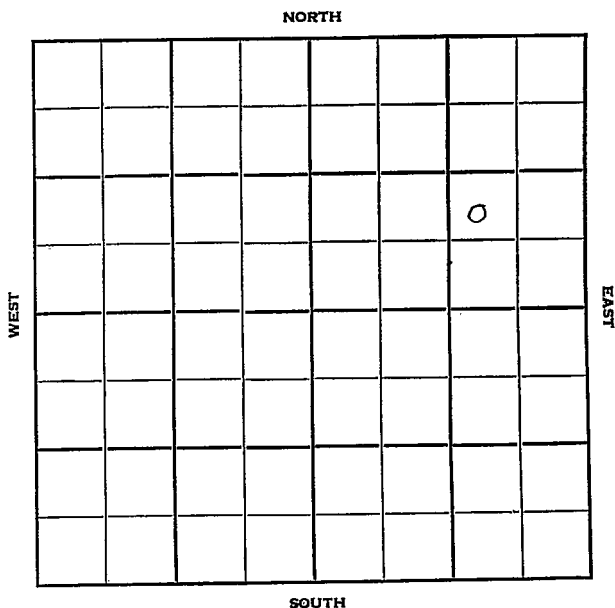

O.W.W.O. Rooks

KANSAS

6

9

18 W

Sec. _____ Twp. _____ R. _____

7 Thompson

Well No. _____ Farm

Continental Oil

Company

Lohman & Johnson

Contractor

Barry Pool


~~1650~~ Ft. from N. Line

990 Ft. from S. Line

990 Ft. from E. Line

Ft. from W. Line

NW SE NE

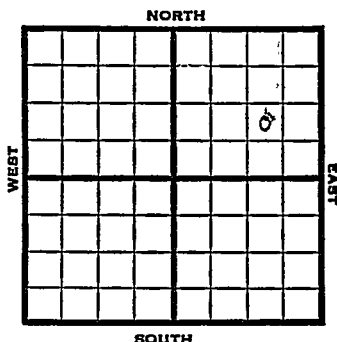

1951

Elev. 2067' REPORT

9/12

Spud 9-9-51
 10-3/4" @ 202
 Drlg. 1250'

1952
1/2

Spud 9-9-51
 D&A TD 3490
 10-3/4" @ 202
 Lans. 3235
 DST 3394-3437 open $\frac{1}{2}$ hr. rec. 15' OCM
 Arb. 3486-90
 7" @ 3487 CO to 3452 48/ 3424-40
 1000 A 84/ 388-3416 3000 A
 S/ 4 BW tr. oil 10 hr. S/ wtr.
 & tr. oil SP 3490
 D&A

ABANDONED
O.W.W.O.

1955
4/27

Oil well TD 3490' OTD 3490
 PB 3368 7" @ 3487' Lans 3235'
 Arb. 3486' CO to 3490
 P/124 BO 12 hr. P/248 BO 24 hrs.
 Comp. 376 BOPD

FIRST REPORT

←
COMPLETED

County Rooks State Kansas

Sec. 6 (Blk. 9) (Sur. 1 SW) Map No. _____

Operator Continental Oil

Well No. **7** Farm **Thompson**

Elev.	Location	NW	SE	NE
-------	----------	----	----	----

0

FIRST REPORT

1650 Ft. From N Line NRE

990 Ft. From E Line Quarter

1st. Report SEP 12 1951

Completion

Remarks

Lohman & Johnson - Contr.


Spudding Date 9-9-51

Drig. Data **Barry Pool**

10 3/4" @ 202 drlg. 1250

J. E. TYRA

County _____ Rocks _____ State Kansas
 Sec. 6 (Blk. Twp.) 9 (Sur. Rge.) 18W Map No. _____
 Operator Continental Oil
 Well No. 7 Farm Thompson
 Elev. 2067 Location NW SE NE

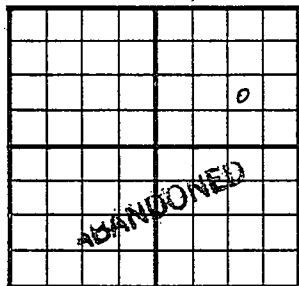

1650 Ft. From N Line NE

990 Ft. From E Line Quarter

1st. Report

Completion JAN 2 1952

Remarks Barry Pool

Lohman & Johnson - Contr.

Spudding Date 9-9-51

Drlg. Data D & A TD 3490

10 3/4" @ 202 Lans. 3235 DST 3394-3437

open 1/2 hr. Rec. 15' ocm Arb. 3486-90


7" @ 3487 CO to 3452 48/ 3424-40

1000 A 84/ 3388-3416 3000 A S/ 4 bw

tr. oil 10 hr. S/ water & tr. oil

SP 3490 D & A

J. E. TYRA

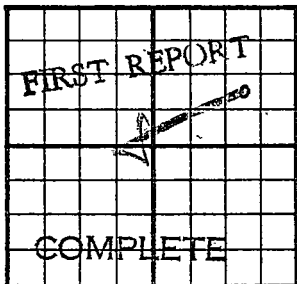O.W.W.O.County _____ Rocks _____ State **Kansas**Sec. **6** (Blk.) _____ (Sur.) _____ (Twp.) **9** (Rge.) **18W** Map No. _____Operator **Continental Oil**Well No. **7** Farm **E. A. Thompson**Elev. _____ Location **NW SE NE**990 Ft. From **S** Line **NE**990 Ft. From **E** Line Quarter1st. Report **APR 27 1955**Completion **APR 27 1955**

Remarks

OWO

Spudding Date _____

Drig. Data **Oilwell** **TD 3490****OTD 3490** **PB 3368** **7" @ 3490** **O.W.W.O.****Lans. 3235** **Arb. 3486** **CO to 3490****P/ 124 bo 12 hr.** **P/ 248 bo 24 hr.****Comp. 376 bopd****FABEN GILSTRAP**