


Graham

KANSAS

SECTION 6 TOWNSHIP 9S RANGE 23W

WELL NO. #1 Staggers

COMPANY Francis Raymond & Leben Drlg.

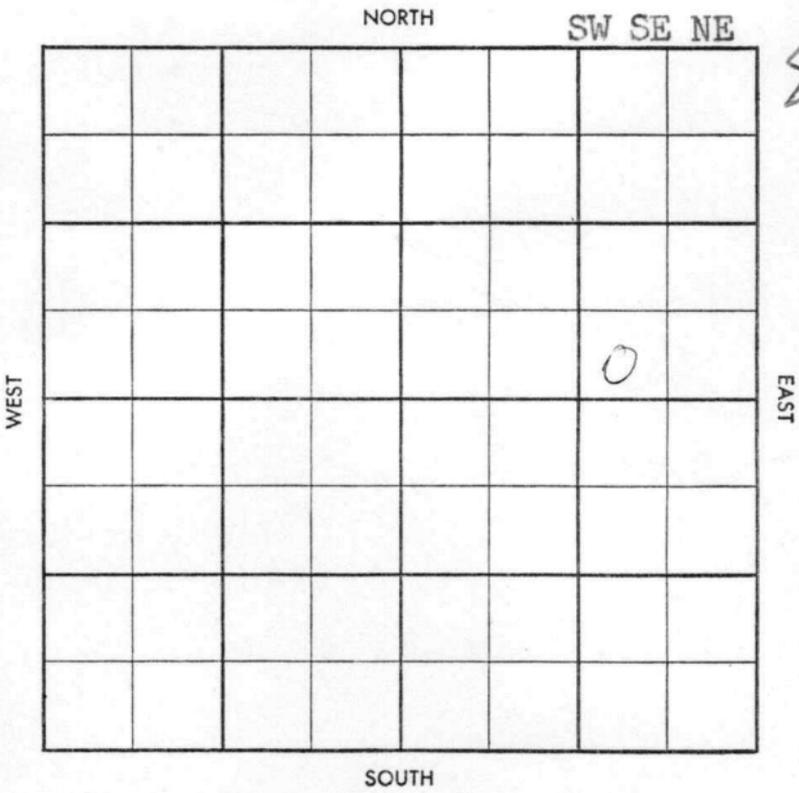

Twp. Pool
 Co. Facet

S-513.B

County Graham Elev. 23270' 2330'
 Sec. 6 Twp. 9 Rge. 23W
 Company Francis Raymond and Leben Drlg.
 Farm Name Staggers No. 1

TOPS	DEPTH	LOG	DATUM
Anh.	1976		
Tp.			
H.		3635	
Tr.			
Dg.			
B.L.			
L.		3674	
K.C.			
B.K.C.		3898	
Ce.			
C.			
M.			
M.			
K.			
Mz.			
Mq.			
V.			
S.			
S.			
A.			
R.			
Pf.			
G.			
T.D.	3910	3910	

Loc. in Sec. SW SE NE
 Geol.
 Contr. Leben #1
 Pool Wildcat
 ABANDONED
 APR 30 '58

Date Comm. 4-16-58 8" 216/165
 Location APR 23 '58 ~~3335~~ 3305 APR 30 '58
DST 3700-16 op/hr 68' MSW FP
14-32 BHP 1260/20" DST
3721-35 1hr 49' M BHP 37/20"

D & A