


Graham

KANSAS

SECTION 6 TOWNSHIP 9 RANGE 24 W

WELL NO. #1 Clark

COMPANY Empire Drlg.

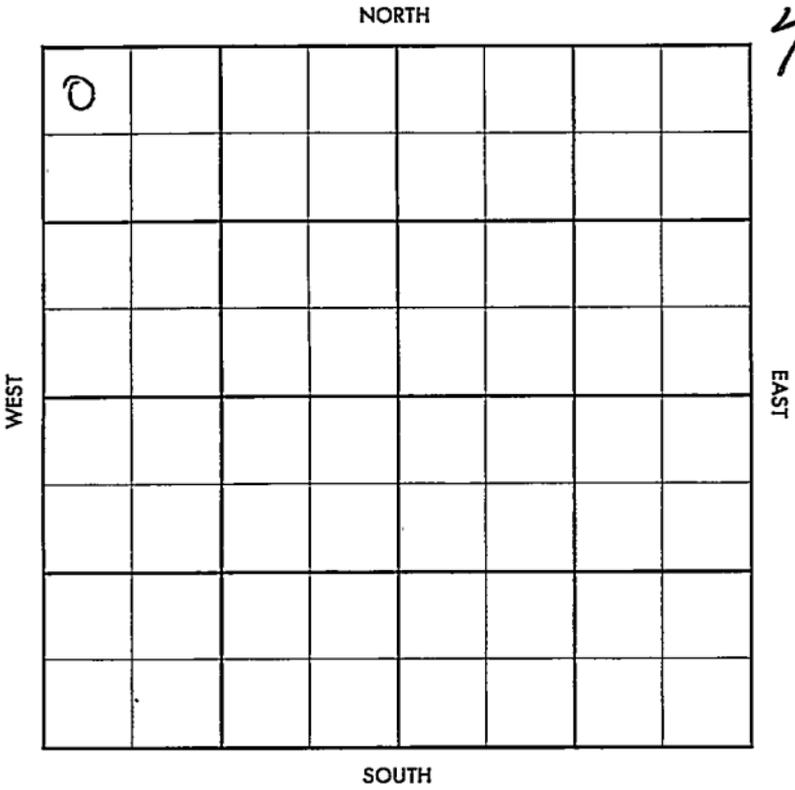

Graham

KANSAS

SEC.	TWP.	R.
6	9	24W

WELL NO. #1 Clark FARM

COMPANY Empire Drlg.

CONTRACTOR Co. Tools

		NORTH				
_____ Ft. from N. Line	0					
_____ Ft. from S. Line						
_____ Ft. from E. Line						
_____ Ft. from W. Line						
NW NW NW						
		SOUTH				

1955	ELEVATION 2507'	REPORT
------	--------------------	--------

12-14 Comm. 12-9-55
8" @ 169/115
Drlg. 2560

1956
2-1

DST 3858-75 op 1 hr. rec. 455' sw,
1340/20"
DST 3971-80 op 45 min. rec. 60' ms
1350/30"
DST 3985-4000 op 1/2 hr. rec. 30' mud
120/30"
DST 3972-4000 op 1 hr. rec. 20' mud, 0#
DST 3998-4020 op 1 hr. rec. 115' o&gcm
30' mco, 90' oil, 790/30"
Enh. 2006
H. 3802
Tr. 3824
L. 3840
TD 4042
5 1/2" @ 4036
CO to 4023, 16/ 4010-14
S/ 3 boph, 3000 A
S/ 5 boph, 10% wtr.,
Comp. 132 bopd.

COMPLETED

County Graham Elev. _____
 Sec. 6 Twp. 9 Rge. 24W
 Company Empire Drlg.
 Farm Name Clark No. 1

TOPS	DEPTH	LOG	DATUM
Anh.			
Tp.			
H.			
Tr.			
Dg.			
BL.			
L.			
K.C.			
B.K.C.			
Ce.			
C.			
M.			
M.			
K.			
Mz.			
Me.			
V.			
S.			
S.			
A.			
R.			
PE.			
G.			
T.D.			

Loc. in Sec. NW NW NW
 Geol. _____
 Contr. Co. tools
 Pool W. Holley
 FIRST REPORT
 DEC 14 '55

Date Comm. 12-9-55
8" @ 169/115 drlg. 2560

[Handwritten scribble]

Co.
 Use.
 No.
 Sec.
 T.
 R.

County Graham Elev. 2507
 Sec. 6 Twp. 9 Rge. 24W
 Company Empire Drlg.
 FarmName Clark No. 1

Co.

TOPS	DEPTH	LOG	DATUM	Loc. in Sec.																														
Anb.	<u>2004</u>			NW NW NW																														
Ip.																																		
H.	<u>3802</u>																																	
Tr.	<u>3824</u>																																	
Dg.																																		
Bl.																																		
L.	<u>3840</u>		<u>1333</u>	Geol.																														
K.C.				Contr.																														
B.K.C.				Co. tools																														
Ce.																																		
C.				Pool																														
M.				W. Holley																														
M.				<table border="1"> <tr><td>o</td><td></td><td></td></tr> <tr><td></td><td></td><td></td></tr> <tr><td></td><td></td><td></td></tr> <tr><td></td><td></td><td></td></tr> <tr><td></td><td></td><td></td></tr> <tr><td></td><td></td><td></td></tr> <tr><td></td><td></td><td></td></tr> <tr><td></td><td></td><td></td></tr> <tr><td></td><td></td><td></td></tr> <tr><td></td><td></td><td></td></tr> </table>	o																													
o																																		
K.																																		
Mz.																																		
Ma.																																		
V.																																		
S.																																		
S.																																		
A.																																		
R.																																		
Pe.																																		
G.				COMPLETE																														
T.D.	<u>4042</u>																																	

Use.

No.

Sec.

T.

R.

Date Comm. 12-9-55 FEB 1 1956
 8" @ 169/115 DST 3858-75 open 1 hr.
 rec. 455' sw 1340/20" DST 3971-80
 open 45 min. rec. 60' msw 1350/30"
 DST 3985-4000 open 1/2 hr. rec. 30' mud
 120/30" DST 3972-4000 open 1 hr.
 rec. 20' mud off DST 3998-4020
 open 1 hr. rec. 115' o & gcm 30' mco
 90' oil 790/30"

5 $\frac{1}{2}$ " @ 4036 GO to 4023 16/ 4010-14
S/ 3 boph 3000 A S/ 5 boph 10% wtr.
Comp. 132 bopd .

R.G.

FEB 9 1956