


Section 6 Township 9 Range 24W

Well No. #3 Clark "A"

Company Empire Drlg.

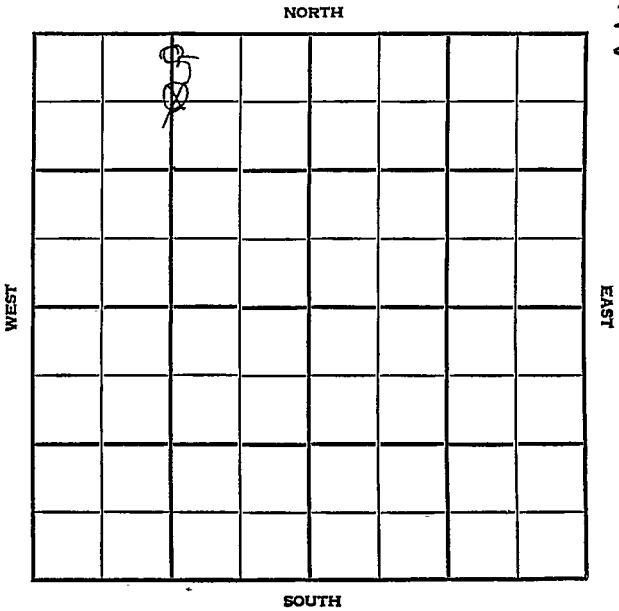

Graham

KANSAS

SEC.

TWP.

R.

6

9

24W

WELL NO.

#3 Clark "A"

FARM

COMPANY

Empire Drlg.

CONTRACTOR

Co. Tools


W. Holley

____ FT. FROM N. LINE

____ FT. FROM S. LINE

____ FT. FROM E. LINE

____ FT. FROM W. LINE

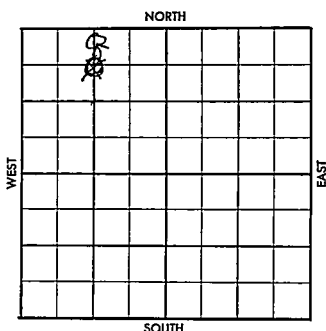~~G N $\frac{1}{2}$ NW~~N $\frac{1}{2}$ N $\frac{1}{2}$ NW

1956

ELEVATION

2494 DF

REPORT

4000' test

7-18

Location

8-22

Comm. 7-19-56

8 5/8" @ 178 w/115

DST 3882-95 op 1 hr., rec. 15' mud,
820/30".

5 1/2" @ 3998 w/75

CO 4005

S/ 22 boph, 4 hrs., no/wtr.,

Ph P/132 bopd, no/wtr., Grav. 41.

Anh. 2190'; H. 3787'; Tr. 3809';

KC. 3826';

TD 4005'

COMPLETED

County Graham Elev. _____
 Sec. 6 Twp. 9 Rgs. 24W
 Company Empire Drilg.
 Farm Name Clark "A" No. 3

TOPS	DEPTH	LOG	DATUM	Loc. in Sec.
Anh.				C N $\frac{1}{2}$ NW
Tp.				4000' test
H.				
Tr.				
Dg.				
Bl.				
L.				Geol. _____
K.C.				Contr. _____
B.K.C.				Co. tools
Ce.				Pool
C.				W. Holley
M.				
M.				
K.				
Mz.				
Me.				
V.				
S.				
S.				
A.				
R.				
Pe.				
G.				
T.D.				

FIRST REPORT

Date Comm. JUL 18 '56

Location

LOC. S. 100.



CORRECTION

FORM 513 SUNRAY

County Graham Elev. 2494 DF
 Sec. 6 Twp. 9 Rge. 24W
 Company Empire Drig.
 FarmName Clark "A" No. 3

TOPS	DEPTH	LOG	DATUM	Loc. in Sec.
Anh.	2190			N2 N2
Tp.				300' test
H.	3787			
Tr.	3809			
Dg.				
BL.				
L.				Geol.
K.C.	3826			Contr.
BXC.				Co. tools
Ce.				Pool
C.				Holley
M.				
M.				
K.				
Mz.				
Me.				
V.				
S.				
S.				
A.				
R.				
PE.				
G.				
T.D.	4005			

AUG 2 2 1956

Date Comm.

Location JUL 25 '56 7-19-56 858 178'
 1115 17 3400 AUG 1 '56 DST 3882-95
 1 hr rec 15' Md (Gcomail) 820/30
 5 1/2 @ 3998/75 AUG 8 '56 CO 4005
 13 @ 22 Boph 4 hrs no/w
 POP AUG 15 '56 ✓ AUG 22 '56 Ph P. 132
 Bopd no/w gran 41°