

(WH8-DC40)✓


Graham

KANSAS

SECTION 6 TOWNSHIP 9S RANGE 24W

WELL NO. #1 Keith "C"

COMPANY Imperial

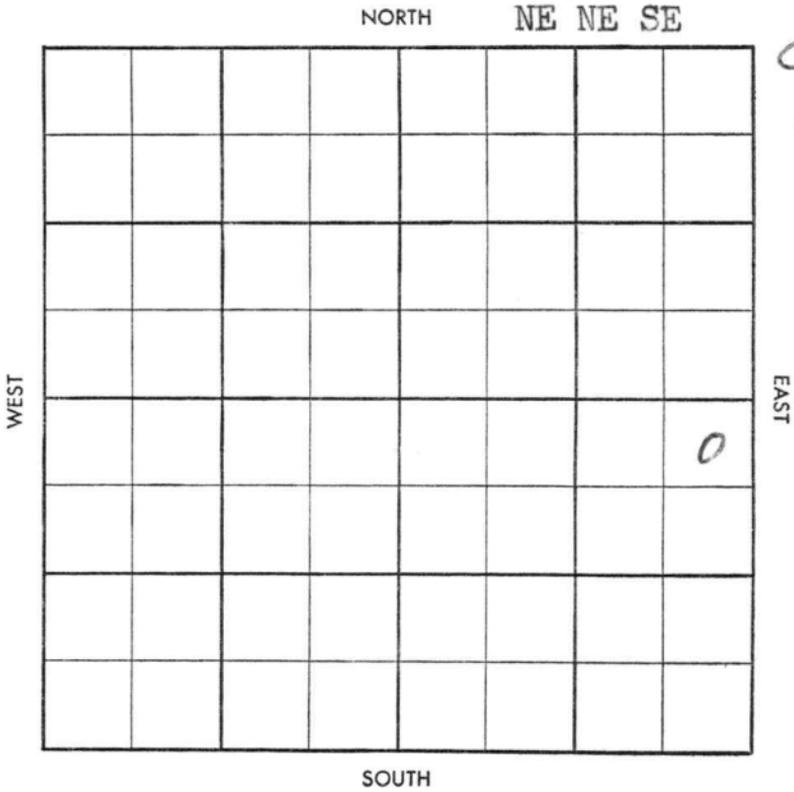

HOT FILE Graham KANSAS

SEC. 6 TWP. 9 S R. 24 W

WELL NO. **# 1 Keith "C"** FARM

COMPANY **Imperial Oil of Kansas, Inc.**

CONTRACTOR **Company tools**


Holley Pool

_____ FT. FROM N. LINE

_____ FT. FROM S. LINE

_____ FT. FROM E. LINE

_____ FT. FROM W. LINE

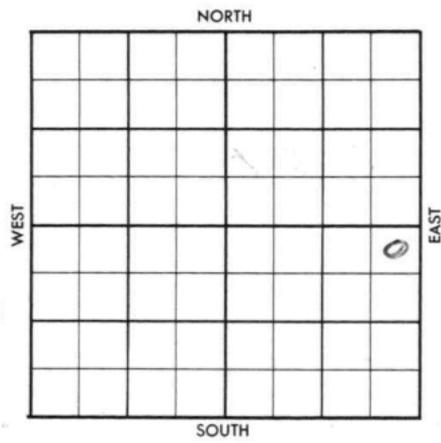

NE NE SE

SDX-DHC-\$2500.00 (S-18616)

1958 ELEVATION REPORT **(WH8-DC40)**

8/14 Base Kansas City at appx 4060'
 To be commenced by Sept. 1, 1958
 To be completed by Oct. 1, 1958
 (See copy DHC Agrt 8-13-58)

~~8/18X~~
 8/14 Spud 8-9-58 8" @ 218/w/150
 Drlg. 2945' (FR Tkt) (WH-Wkly Ltr)

8/22 DST 3960-80' open 1 hr, rec 20' M
 BHP Off. Heeb 3771' Tr. 3796'
 Lsg. 3811' TD 4045' D & A
(WH-Wkly Sct. Ltr)

8/20 Spud 8-9-58
 8" @ 218 w/150
 Tops: Anhy 2185', Heeb 3771', Tr. 3796'
 Lans 3811'
 DST 3960-80', open 1 hr rec 20' Mud
 BHP Off.
 TD 4045'. Ran log. D & A
 (Scout Completion ticket)

ABANDONED ✓

116
 ✓

S-513-B

County Graham Elev. _____
 Sec. 6 Twp. 9S Rge. 24W
 Company Imperial
 Farm Name Keith "C" No. 1

TOPS	DEPTH	LOG	DATUM
Anh.	<u>2185</u>		
Tp.			
H.			
Tr.			
Dg.			
B.L.			
L.			
K.C.			
B.K.C.			
Ce.			
C.			
M.			
M.			
K.			
Mz.			
Mq.			
V.			
S.			
S.			
A.			
R.			
Pf.			
G.			
T.D.			

Loc. in Sec. _____
NE NE SE
(WH8-DC40)

Geol. _____
 Contr. Co. #2

Pool _____
Holley

AUG 13 1958
 FIRST REPORT

Date Comm. 8-9-58 SMC-DHM
8" 218 w/150; D 2945

✓
 SMC

Co.
 Lse.
 No.
 Sec.
 T.
 R.

Twp _____ Pool _____
 Co. _____ Facet _____

Graham Elev. _____
 Sec. 6 Twp. 9S Rge. 21W
 Company Imperial
 Farm Name Keith "C" No. 1

TOPS	DEPTH	LOG	DATUM
Anh.	2185		
Tp.			
H.	3771		
Tr.	3796		
Dg.			
B.L.			
L.	3811		
K.C.	1151		
B.K.C.			
Ce.			
C.			
M.			
M.			
K.			
Mz.			
Mq.			
V.			
S.			
S.			
A.			
R.			
Pf.			
G.			
T.D.	4045		

Loc. in Sec. _____
 NE NE SE
 Geol. _____
 Contr. Co. #2
 Pool _____
 Holley
 ABANDONED
 AUG 20 '58

Date Comm. 8-9-58 S.M.C.-D.H.M.

8" 218 w/150; D 2945 AUG 20 '58 X Tops
 DST 3960-80 1hr rec 20m
 BHP 0 TD 4045 ran Log

D&A

AUG 26 1958

M. M.