


Rooks

KANSAS

SECTION 7 TOWNSHIP 9 RANGE 17 W

WELL NO. #1 Fisher

COMPANY V. D. Sidey

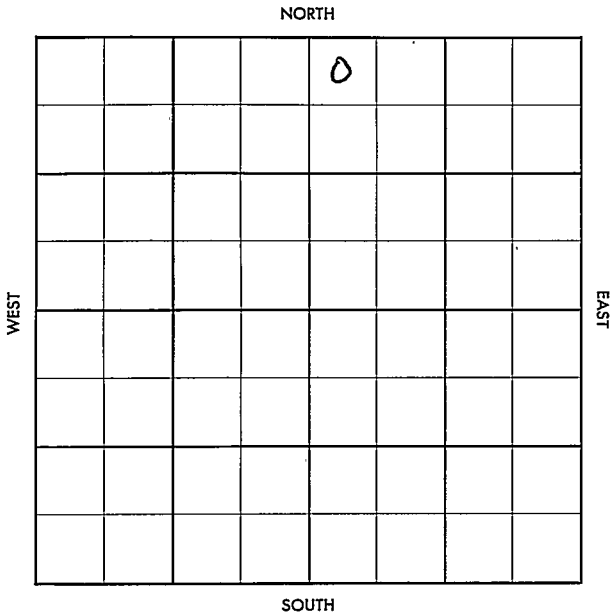

SEC.	TWP.	R.
7	9	17 W

WELL NO.

1 Fisher

FARM

COMPANY

V. D. Sidey

CONTRACTOR

Co. tools

Dopita

Ft. from N. Line

Ft. from S. Line

Ft. from E. Line

Ft. from W. Line

NW NW NE

NORTH

Q

WEST

EAST

SOUTH

SDX - 1/2 Mile

ELEVATION

REPORT

1955

12/14

Comm. 11-30-55
(Tite Hole) Pipe set.

12-22

No report

12-29

11 11

1956

1-6

No report (titehole)

1-12

11

1-19

Drilling in.

1-26

No report

2-2

11

2-10

11

2-16

No report

2-23

11

County Reels Elev. _____
 Sec. 7 Twp. 9 Rge. 17W
 Company V. D. Sidey
 Farm Name Fisher No. 1

TOPS	DEPTH	LOG	DATUM	Loc. in Sec. _____
Anh. ☒				NW NW NE
Tr. ☒				
H.				
Tr.				
Dg.				
Bl.				
L.				Geol. _____
K.C.				Contr. _____
B.K.C.				Co. tools
Ce.				Pool _____
C.				Donita
M.				
M.				
K.				
Mz.				
Me.				
V.				
S.				
S.				
A				
R.				
Pe.				
G.				
T.D.				

Date Comm. 11-30-55 TITE HOLE
pipe set

FIRST REPORT
 DEC 4 '55
 1/2 mile

County Rooks Elev. 1959 RE
 Sec. 7 Twp. 9 Rge. 17W
 Company V. D. Sidey
 Farm Name Fisher No. 1

TOPS	DEPTH	LOG	DATUM	Loc. in Sec.
Ant.	1288			NW NW NE
Top				
H.				
Tr.				
Dg.				
Bl.				
L.	3122		1463	Geol.
K.C.				Center
B.K.C.				Co. tools
Ce.				Pool
C.				Deposits
M.				
M.				
K.				
Mz.				
Mo.				
V.				
S.				
S.	3292		1433	ABANDONED
A.				
R.				
Pe.				
G.				
Ed.	3395			FEB 29 1956

Date Comm. 11-30-55

TITE HOLE

pipe set DEC 21 '55 ✓ DEC 28 '55 ✓ JAN 5 '56 Tite

JAN 11 '56 ✓ CT over hole JAN 18 '56 P in

JAN 25 '56 ✓ FEB 1 '56 ✓ FEB 8 '56 ✓ FEB 15 '56 ✓

FEB 22 '56 FEB 29 '56 5 1/2 3393 ca

3395 no test.

H & A