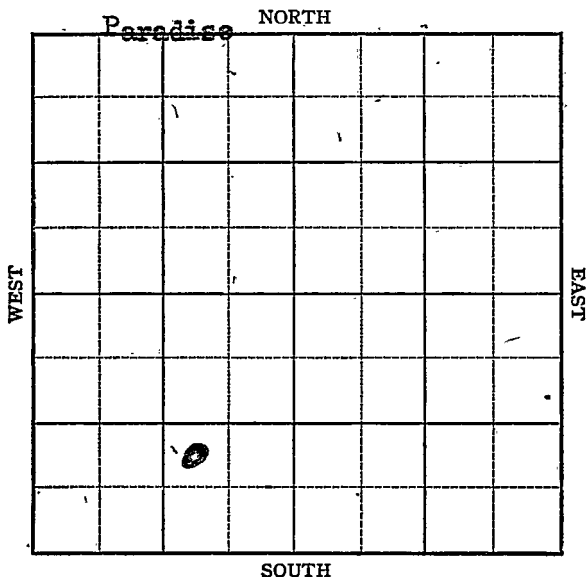


KANSAS

Rooks

FORM 51 IOM 12-46 PETROL

Section 7 Township 9 Range 18WWell No. 6 CabbageCompany H. H. & B. Drlg.

KANSAS

Rooks County

Sec. 7 Twp. 9 R. 18-W

Well No. 6 Cabbage Farm

H. H. & B. Drlg. Company

Paradise Pool


Ft. from N. Line

990 Ft. from S. Line

990 Ft. from E. Line

Ft. from W. Line

NW SE SW

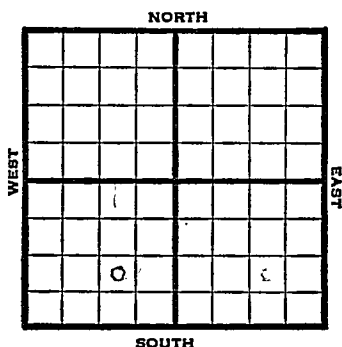

1947 Elev. 2077' REPORT

7/30 10" @ 22 anhy 1434
Drlg. 23858/6 Lansing 3254'
Arbuckle 3500'
TD 3504'
5" @ 3502'
RUST

8/13 "

8/20 "

8/27 "

9/3 "

9/10 "

9/17 "

9/24 m. Lans. 3254'
Arb. 3500'
5" @ 3502'
Pump 25 Pot
28.0 Gr.
TD 3504'

COMPLETED

Map No. _____ Sec. 7 Twp. 9 R. 18W

Well No. 6 Cabbage

H. H. & B. Drlg. Company

FIRST REPORT Contractor

NW SE SW

SECTION PLAT

_____ Ft. from N. Line

990 Ft. from S. Line

990 Ft. from E. Line

_____ Ft. from W. Line

	o		

Rooks County

Location _____

Rig up _____

Drilling and Remarks:

10" @ 22

any 1434

drlg. 2385

RECORD

Cased _____ in., _____ ft.

Sand _____

Gas _____

Oil _____

Total Depth _____

PRODUCTION

1st 24 hrs. Nat. _____

1st 24 hrs. after shot _____

Gas _____ Cu. Ft.

Dry Hole _____

Abandoned _____

Date

JUL 30 1947 19

S. J. LEWIS Scout

Kansas

Map No. 64 Sec. 7 Twp. 9 R. 18WWell No. 6 CabbageH. H. & B. Drlg. Company
COMPLETE

Contractor

NW SE SW

E, 2077
SECTION PLAT

	0	1	

 Ft. from N. Line990 Ft. from S. Line990 Ft. from E. Line Ft. from W. Line

Rooks County

RECORDLocation Cased in., ft.Rig up Sand

Drilling and Remarks:

Gas Oil Total Depth 3504**PRODUCTION**1st 24 hrs. Nat. 1st 24 hrs. after shot Gas Cu. Ft.Dry Hole Abandoned

Date

SEP 24 1947

19

S. J. LEWIS

Scout

Lans 3254
Ar 8000
5' C 3002
Pump 2500

28-1/2