

O. W. P. B.
9Section 7 Township 9 Range 18 WWell No. # 4 WernerCompany Continental

NORTH

			0				

WEST

EAST

SOUTH

O. W. P. B. Rooks

KANSAS

Sec. 7 Twp. 9 R. 18W ✓

Well No. #4 Werner Farm

Continental Company

Holms Drlg. - Contr. Contractor

Barry Pool


330' Ft. from N. Line

 Ft. from S. Line

330' Ft. from E. Line

 Ft. from W. Line

NE NE NW

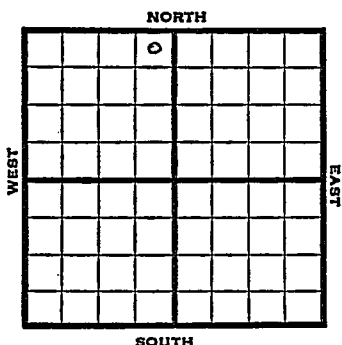

1951 Elev. 2034' REPORT

3/28 Location
6/27 Spud 4-2-51
Oil Well TD 3462
10" @ 203
Anhy 1440-75 Tor. 3193
Lans. 3211
DST 3373-97 opn 1 hr
ec. 40' hocm
Arb. 3459 TD 3461
5" @ 3460
B/15 goph DD 3462 FU 400'
oil 12 hr. S/3/4 boph 500 A
S/17 bo 29 bwph Comp. 33 bopd 6 bw.

COMPLETED

1956

O. W. P. B

5-9 OTD 3462'
5" @ 3460
PB 3425, 24/ 3365-71, 32/ 3380-88,
1000 A
S/ 21 bo, 52 bw, 6 hrs.
PB 3359, 48/ 3341-53, 1000 A, 56/3244-
58.
PB 3234, 46/ 3208-24, 500 A,
CO to 3425
Comp. 38 bopd, 82 BW
L. 3211, A. 3459
FIRST REPORT COMPLETED

County Rooks State KansasSec. 7 (Blk. 9 (Sur. 18W Map No.)
(Twp.) (Rge.)Operator ContinentalWell No. 4 Farm WernerElev. Location NE NE NW

			0				

330 Ft. From N Line NW330 Ft. From E Line Quarter1st. Report MAR 28 1951Completion Remarks Holms Drlg. - Contr.Spudding Date Drlg. Data Barry PoolLocation

J. E. TYRA

J. E. TYRA

O. W. P: B

OWPB

FORM 513 SUNRAY

County Rocks Elev. 2034
 Sec. 7 Twp. 9 Rge. 18W
 Company Conoco
 Farm Name Werner No. 4

TOPS	DEPTH	LOG	DATUM	Loc. in Sec.
Anh.				NE NE NW
Tp.				
H.				
Tr.				
Dg.				
Bl.				
L.	3211			Geol.
K.C.				Contr.
B.K.C.				
Ce.				Pool
C.				
M.				
M.				
K.				
Mz.				
Me.				
V.				
S.				
S.	3459			
A.				
R.				
Pe.				
G.				
T.D.				

	0	
FIRST REPORT		
MAY 9 '56		
COMPLETE		

Date Comm.

OTD 3462 5" @ 3460 PB 3425

24/ 3365-71 32/ 3380-88 1000 A

S/ 21 bo 52 bw 6 hr. PB 3359

48/ 3341-53 1000 A 56/ 3244-58

PB 3234 46/ 3208-24 500 A

CO test 3425/AM Comp. 38 bopd 82 bw

D. R.

