


Section 7 Township 9 Range 19W

Well No. #1 Fregéau

Company Lee Phillips et al.

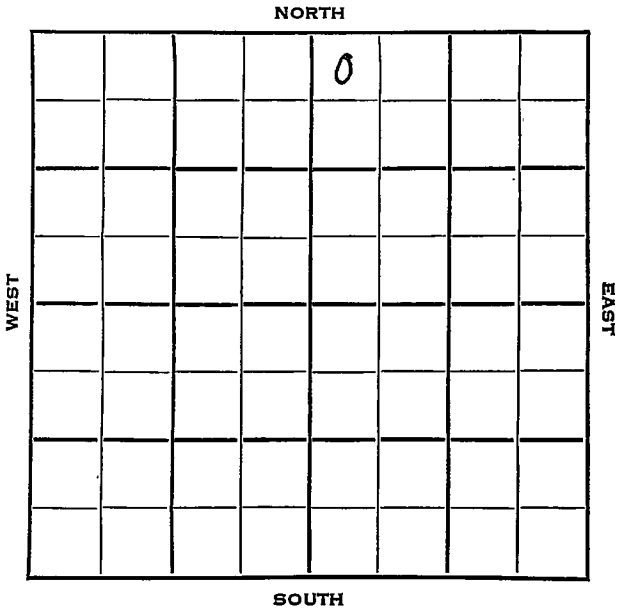

Rooks

KANSAS ✓

Sec. 7 Twp. 9 R. 19W

Well No. #1 Fregeau Farm

Lee Phillips et al Company

Wildcat Contractor

330 Ft. from N. Line

Ft. from S. Line


Ft. from E. Line

330 Ft. from W. Line

NW NWNE

Phillips Farmout & DHM

Skelly - DHM

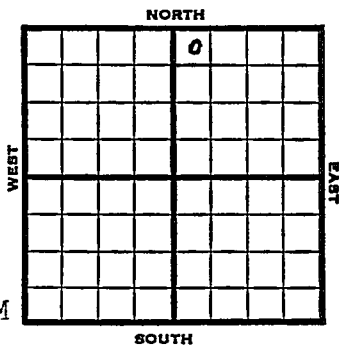

1953

Elev. 2070' REPORT

4/22

MIR

4/30

8" @ 212

Anhy 1520

Drig. 2033'

5/6

Spud 4-24-53 D & A TD 3599

8" @ 212 Anhy 1520 Howard 3055

Top 3089 Heeb 3263 Tor 3285

Lans 3302

DST 3470-75 open 1 hr rec 10' mud O#

B KC 3508 Arb. 3570

TD 3599 D & A

ABANDONED

County Rooks State Kansas

Sec. 7 (Blk. Twp.) 9 (Sur. Rge.) 19W Map No.

Operator Lee Phillips etal.

Well No. 1 Farm Fregeau

Elev. _____ Location NW NW NE

			0		

330 Ft. From N Line NE

330 Ft. From W Line Quarter

1st. Report APR 22 1953

Completion _____

Remarks Phillips farmout & Skelly - DMM DMM

Spudding Date _____

Drlg. Data Wildcat

M I R

County _____ Rocks _____ State Kansas

Sec. 7 (Blk. Twp.) 9 (Sur. Rge.) 19W Map No. _____

Operator Lee Phillips etal.

Well No. 1 Farm Fregeau

Elev. 2070 Location NW NW NE



330 Ft. From N Line NE

330 Ft. From W Line Quarter

Ist. Report

Completion MAY 6 1953

Remarks Wildcat

Spudding Date 4-24-53

Drig. Data D & A TD 3599

8" @ 212 Anhy 1520 Howard 3055

Top. 3089 Heeb. 3263 Tor. 3285

Lans. 3302 DST 3470-75 open 1 hr.

Rec. 10' mud 0# B KC 3508

Arb. 3570 TD 3599

D & A