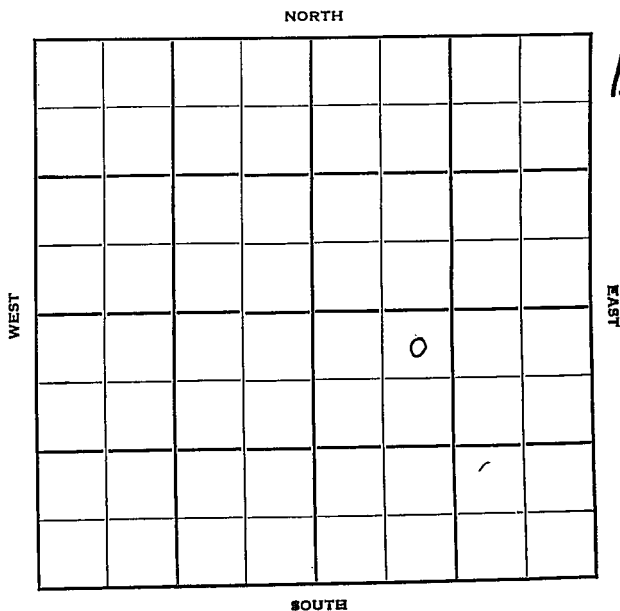


Section 7 Township 9 Range 20WWell No. #1 DesmarteauCompany Skelly

Rooks

KANSAS

Sec. 7 Twp. 9 R. 20W

Well No. #1 Desmarteau Farm

Skelly

Wildcat Company


330' Ft. from N. Line

           Ft. from S. Line

           Ft. from E. Line

990' Ft. from W. Line

NE NW SE

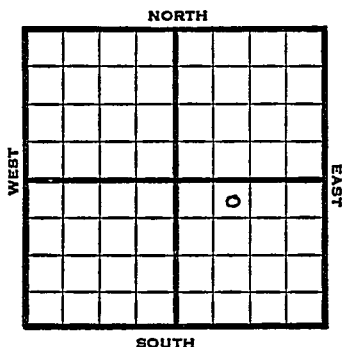

1949

Elev 2159' REPORT

11/23 Location

11/29 "

12/7 "

12/14 "

12/21 8"@ 300'

12/28 Drlg 1400'

1950

1/11 TD 3800'

8"@ 300

Heb 3392'

Tor 3412'

Lan 3433'

Cg 3727'

Arb. 3762-3800' TD

Trace of Oil stain in Arb.

D&A

Aband.

**ABANDONED**

Kansas


Map No. \_\_\_\_\_ Sec. 7 Twp. 9 R. 20WWell No. 1 Desmarteau

Skelly

Company

Contractor

NE NW SE

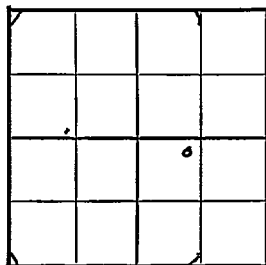FIRST REPORT  
SECTION PLAT330 Ft. from N. Line

\_\_\_\_\_ Ft. from S. Line

\_\_\_\_\_ Ft. from E. Line

990 Ft. from W. Line

Rooks County

Location X

Rig up \_\_\_\_\_

Drilling and Remarks:

## RECORD

Cased \_\_\_\_\_ in., \_\_\_\_\_ ft.

Sand \_\_\_\_\_

Gas \_\_\_\_\_

Oil \_\_\_\_\_

Total Depth \_\_\_\_\_

## PRODUCTION

1st 24 hrs. Nat. \_\_\_\_\_

1st 24 hrs. after shot \_\_\_\_\_

Gas \_\_\_\_\_ Cu. Ft.

Dry Hole \_\_\_\_\_

Abandoned \_\_\_\_\_

Date

NOV 23 1949 19

S. J. LEWIS

Scout

Kansas

Wildcat

Map No. \_\_\_\_\_ Sec. 7 Twp. 9 R. 20WWell No. 1 Desmarteau

Skelly

Company


Contractor

NE NW SE

Elev: 2159  
SECTION FLAT330 Ft. from N. Line

\_\_\_\_\_ Ft. from S. Line

\_\_\_\_\_ Ft. from E. Line

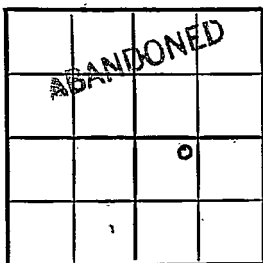990 Ft. from W. Line

Rooks County

## RECORD

Location \_\_\_\_\_

Cased \_\_\_\_\_ in., \_\_\_\_\_ ft.

Rig up \_\_\_\_\_

Sand \_\_\_\_\_

Drilling and Remarks:

Gas \_\_\_\_\_

8" @ 300

Oil \_\_\_\_\_

Feb 3392

Total Depth 3800

Tor 3412

## PRODUCTION

Lan 3433

1st 24 hrs. Nat. \_\_\_\_\_

Cg 3727

1st 24 hrs. after shot \_\_\_\_\_

Arb 3762 - 3800 T.D.

Gas \_\_\_\_\_ Cu. Ft.

Trace oil stain in

Dry Hole \_\_\_\_\_

Arb. D &amp; A.

Abandoned ☒

Date

JAN 11 1950 19

J. E. TYRA.

Scout