


Section 7 Township 9 Range 21W

Well No. 1 Cooley

Company D. G. Hanson & C & G Drlg.

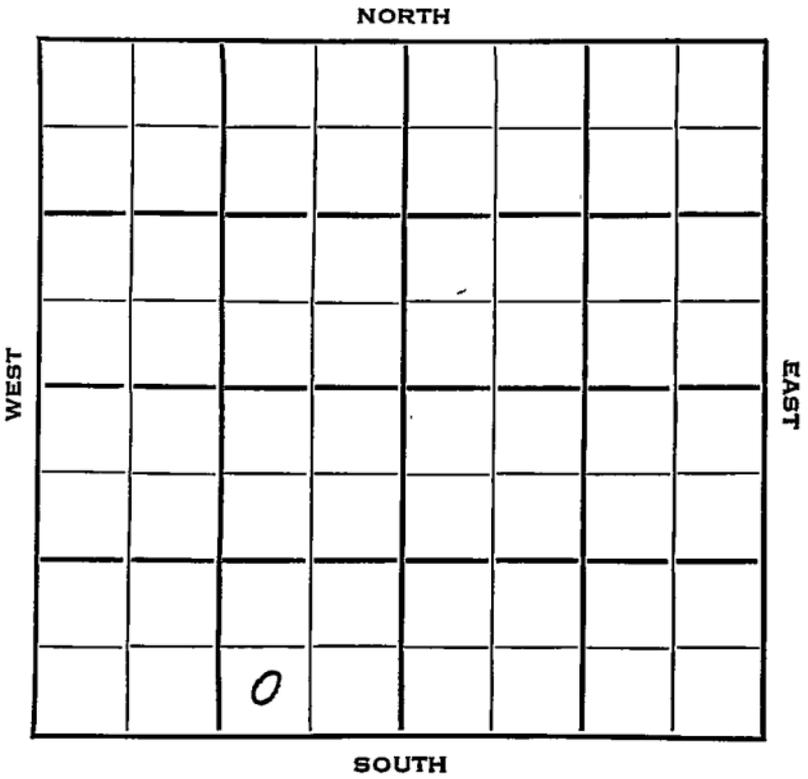

Sec. 7 Twp. 9 R. 21 W

Well No. # 1 Cooley Farm

D. G. Hanson & C & G Drlg. Company

C & G Drlg. Contractor


Morel Pool

Ft. from N. Line

330 Ft. from S. Line

990 Ft. from E. Line

Ft. from W. Line

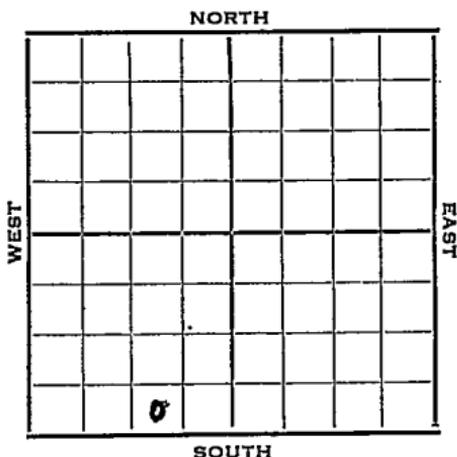

SW SE SW
Lion Oil Farmout

1953 Elev. 2314' REPORT

- 7/29 Spud 7-27-53
8" @ 162 WOC
- 8/5 Anhy 1809, Heeb 3480, Tor 3505, Lans 3520
DST 3699-3713, 1 hr., 155' hly ocm, 1175#
Arb. 3823
RTD 3827
- 8/12 5" @ 3825 CO 3827 FU 2200' oil
- 8/19 S/10 BOPH POP
- 8/26 N.R.
- 9/9 Spud 7-27-53
Oil Well
TD 3827
8" @ 162
Anhy 1809, Heeb 3480, Tor 3505, Lans 3520
DST 3699-3713, opn 1 hr., rec. 155' hocom, 1175#
Arb. 3823
TD 3827
5" @ 3825
CO to 3827, FU 2200' oil
S/10 boph
Comp. 265 bopd

COMPLETED


County Graham State Kansas

Sec. 7 (Blk. 9) (Sur. 21W) (Twp.) (Rge.) Map No.

Operator D. G. Hansen & C & G Drlg.

Well No. 1 Farm Cooley

Elev. 2314 Location SW SE SW

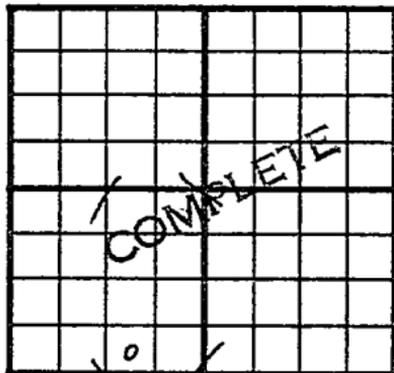

330 Ft. From S Line SW

990 Ft. From E Line Quarter

Ist. Report

Completion SEP 9 1953

Remarks Morel Pool

C & G Drlg. - Contr.

Spudding Date 7-27-53

Drlg. Data Oil well TD 3827

8" @ 162 Anhy 1809 Heeb. 3480

Tor. 3505 Lans. 3520 DST 3699-3713

open 1 hr. Rec. 155' hocm 1175#

Arb. 3823 TD 3827 5" @ 3825 CO to 3827

FU 2200' oil S/ 10 boph

Comp. 265 bopd