


Section 7 Township 9 Range 21W

Well No. #1 Gooley

Company Harry Gore

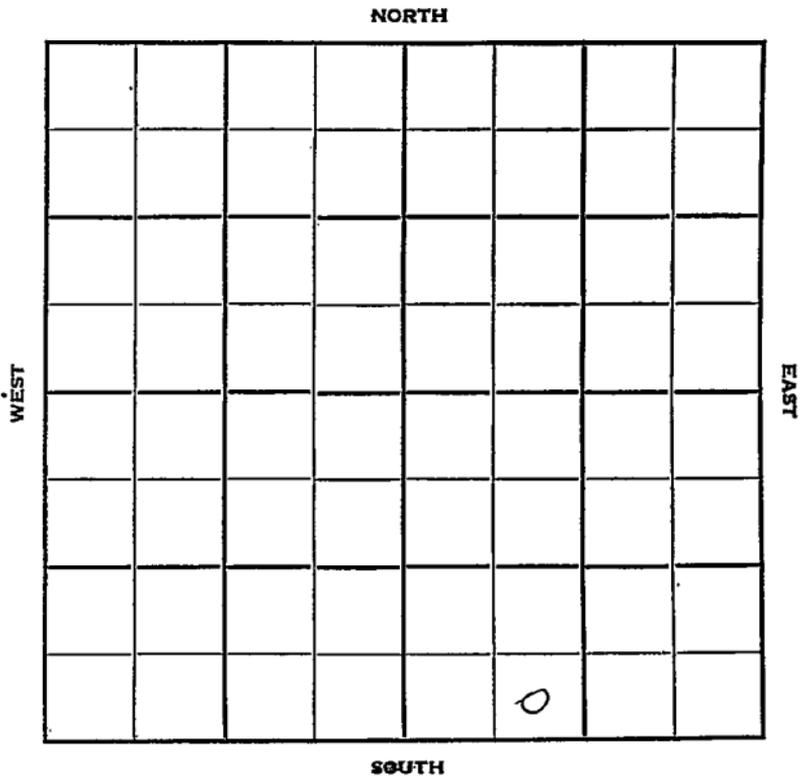

Graham

KANSAS

Sec. 7 Twp. 9 R. 21W

Well No. #1 Cooley Farm

Harry Gore Company

B & R Drlg. - Contr. Contractor


Morel Pool

Ft. from N. Line

330' Ft. from S. Line

Ft. from E. Line

990' Ft. from W. Line

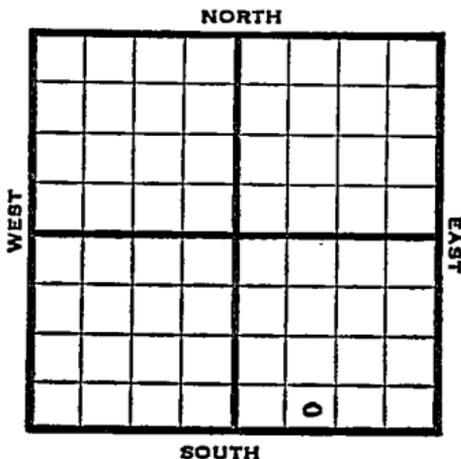

SE SW SE

1951

Elev. 2261' REPORT

1/24  
2/28

Location

Spud 2-7-51

D&A TD 3837

8" @ 178

Heeb. 3440' Lans. 3478'

BKC 3698' Con. 3769'

Arb. 3812-37 TD

D&A

**ABANDONED**


County Graham State Kansas

Sec. 7 (Blk. Twp.) 9 (Sur. Rge.) 21W Map No.

Operator Harry Gore

Well No. 1 Farm Cooley

Elev. Location SE SW SE

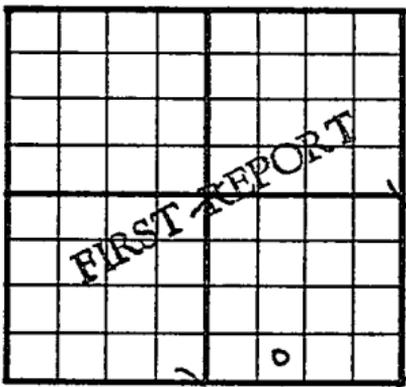

330 Ft. From S Line SE

990 Ft. From W Line Quarter

Ist. Report JAN 24 1951

Completion

Remarks

B & R Drlg. - Contr.

Spudding Date

Drlg. Data Morel Pool

Location

