



Section 7 Township 9 Range 21 W

Well No. # 1 Cooley

Company Lion Oil

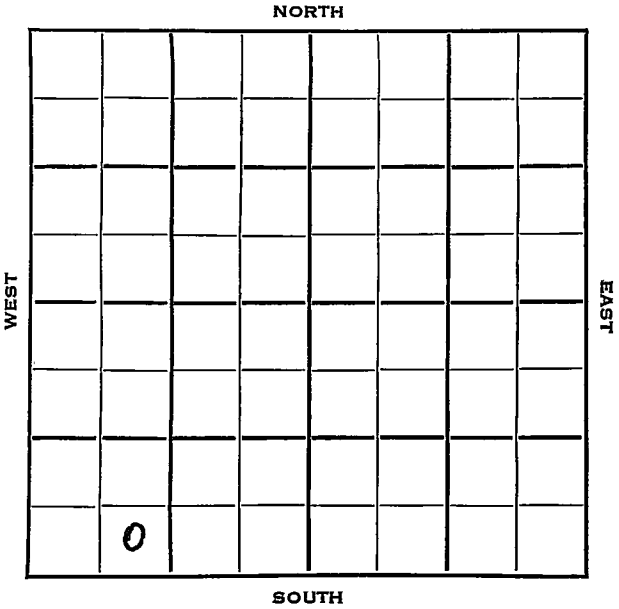

County Graham State Kansas
 Sec. 7 (Blk. 9 (Sur. 21W Map No. 9)
 Operator Lion Oil
 Well No. 1 Farm Cooley
 Elev. 2300 Location SE SW SW

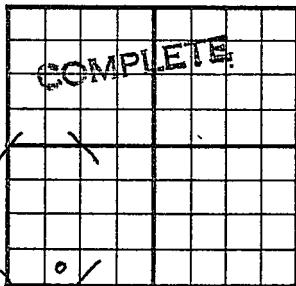

330 Ft. From S Line SW
990 Ft. From W Line Quarter
 1st. Report
 Completion DEC 30 1953
 Remarks Morel Pool
Rine Drlg. - Contr.
 Spudding Date 11-17-53

Drlg. Data Oil well TD 3815

8" @ 200 Heeb. 3467 Tor. 3495

Lans. 3505 DST 3508-25 open 1 hr.

Rec. 40' vhocm 60' oily wtr. 90' wtr.

1120# DST 3532-58 open 1 hr. Rec.

60' hg & ocm 1100' gassy oil 250' wtr.

1220# DST 3570-3600 open 1 hr. Rec.

45' o & gcm 360' muddy oil 1320#

DST 3686-97 open 40 min. Rec. 9' mud

0# B KC. 3706 Arb. 3812 TD 3817

5" @ 3815 SCHLUMBERGER TOPS

Heeb. 3466 Tor. ~~3491~~ Lans. 3504

B KC 3707 Arb. 3810 TD 3815 CO to 3815

B/ 1½ boph DD 3819 B/ 2 boph 500 A

S/ 45 bo Comp. 2316 bopd. 16% wtr.

J. G. McGEHEE