


Section 7 Township 9 Range 21 W

Well No. # 2 Cooley

Company Peel-Hardman

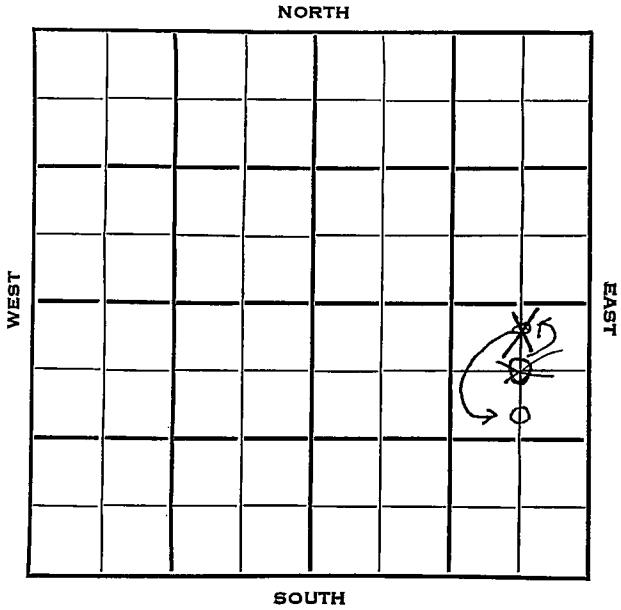

Sec. 7 Twp. 9 R. 21W

Well No. #2 Cooley Farm

Peel-Hardman Company

Peel Bros. Contractor

Morel Pool


~~790~~
~~330~~
~~660~~

660 Ft. from N. Line

_____ Ft. from S. Line

660 Ft. from E. Line

_____ Ft. from W. Line

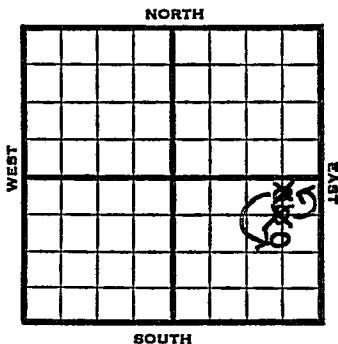

~~C NE SE~~

~~C 1/2 NE SE~~

~~C 5/8 NE SE~~

1953

Elev. 2239' REPORT

7/1
7/8

MIR
Heeb 3413, Lans 3455,
Drlg 3660'

7/22

B KC 3665' Arb. 3772'
RTD 3775 5" @ 3773 DD

7/29

CO 3775, 500A, S/3 boph

8/5

Oil Well
TD 3775'
8" @ 170
Anhy 1738, Heeb 3413, Lans 3455,
B KC 3665, Arb 3772
TD 3775
5" @ 3773, CO to 3775, 500A
S/3 boph
Comp. 86 bopd 6% wtr.

COMPLETED

County Graham State Kansas

Sec. 7 (Blk. Twp.) 9 (Sur. Rge.) 21W Map No.

Operator Peel - Hardman

Well No. 2 Farm Cooley

Elev. _____ Location C NE SE

FIRST REPORT

660 Ft. From N Line SE

660 Ft. From E Line Quarter

Ist. Report JUL 1 1953

Completion _____

Remarks _____

Peel Bros. - Contr.

Spudding Date _____

Drlg. Data Morel Pool

M I R

Map No. _____ Sec. 7 Twp. 9 R. 21W

Well No. 2 Cooley

Peel-Hardman Company

Contractor

C N/2 NE SE


330 Ft. from N. Line

_____ Ft. from S. Line

660 Ft. from E. Line

_____ Ft. from W. Line

SECTION PLAT

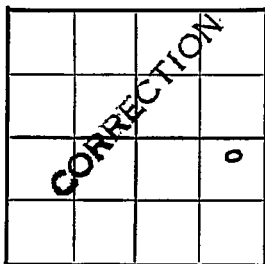

Location _____

Rig up _____

Drilling and Remarks:

Reported
C NE SE

RECORD

Cased _____ in., _____ ft.

Sand _____

Gas _____

Oil _____

Total Depth _____

PRODUCTION

1st 24 hrs. Nat. _____

1st 24 hrs. after shot _____

Gas _____ Cu. Ft.

Dry Hole _____

Abandoned _____

Date

JUL 8 1953

J. G. McGEHEE

Kansas

Map No. _____ Sec. 7 Twp. 9 R. 21WWell No. 2 Cooley

Peel - Hardman _____ Company

CONNECTION _____ Contractor

C S L NE SE

SECTION PLAT

990 Ft. from N. Line

_____ Ft. from S. Line

660 Ft. from E. Line

_____ Ft. from W. Line

			o

Graham County

Location _____

Rig up _____

Drilling and Remarks:

Recorrected
from
C N L NE SE

RECORD

Cased _____ in., _____ ft.

Sand _____

Gas _____

Oil _____

Total Depth _____

PRODUCTION

1st 24 hrs. Nat. _____

1st 24 hrs. after shot _____

Gas _____ Cu. Ft.

Dry Hole _____

Abandoned _____

Date

JUL 22 1952 19

J. G. McGEHEE

Scout

