

DX 78-1


Graham

KANSAS

Section 7 Township 9 Range 21W

Well No. #2 Shaw

Company N C R A

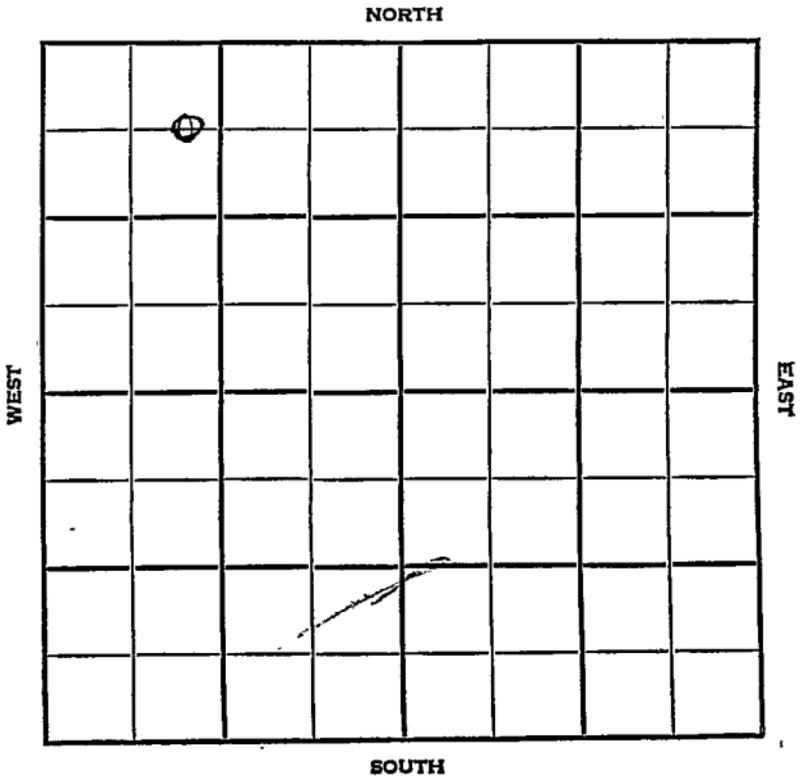

County Graham Elev. \_\_\_\_\_  
 Sec. 7 Twp. 9N Rgs. 21W  
 Company N C R A  
 FarmName Sharr No. 2

TOPS	DEPTH	LOG	DATUM
Anh.	1795		
TP.			
H.			
Tr.			
Dg.			
Bl.			
L.			
K.C.			
B.K.C.			
Ce.			
C.			
M.			
M.			
K.			
Mz.			
Me.			
V.			
S.			
S.			
A.			
R.			
PE.			
G.			
T.D.			

Loc. in Sec. C E  $\frac{1}{2}$  NW NW

Geol. \_\_\_\_\_

Contr. \_\_\_\_\_

Lewis Drlg.

Pool \_\_\_\_\_

Morel

°		
JAN 9 '57		
FIRST REPORT		

Date Comm. 1-11-57  
8" @ 278/175 drlg. 2590

3

Co. Use. Co. No. Sec. T. R.

County Graham Elev. 2273  
 Sec. 7 Twp. 21N  
 Company N C D A  
 Farm Name Shaw No. 2

TOPS	DEPTH	LOG	DATUM	Loc. in Sec.
Anh.	1795			C E $\frac{7}{8}$ NW NW
Ip.				
H.	3466			
Tr.	3491			
Dg.				
Bl.				
L.	3508			Geol.
K.C.				Contr.
B.K.C.				Lewis Drlg.
Ce.				Pool 11602 184
C.				Morel
M.				
M.				
K.				
Mz.				
Me.				
V.				
S.				
S.				
A.	3850			
R.				
Pe.				
G.				
TD	3855			

COMPLETE

Date Comm. 1-1-57  
 8" @ 278/175 drlg. 2590  
 DST 3538-58 1hr 125' SW  
 FP 25-55 BHP 1225' 200'  
 DST 3566-78 1hr 5' SW  
 FP 20-25 BHP 1125' DST  
 3578-89 1hr 5' md All  
 press. 0 DST 3636-50 90" rec  
 225' G.P. rec 100' H.O.E.G.M. +  
 75' oil BHP 1320-1160/20"

DST. 3664-83 1hr 65' HOCM  
+5' Free oil BHP 1290'

DST 3688-3707 2 1/2 hrs 550'  
SW FP 30-270 BHP 1150'

Ø 3767 16 23" 572 @ 385' JAN 20 57

CO 3819 GRNL 12/3676

-79 Ø 5 GW + SC. oil M

\$ 242 BFph 13 \$ 41

BF (10% wt) 2 hrs Pop

FEB 8 57 ✓ FEB 13 57 FEB 20 57 FEB 27 57 MAR 6 57

Ph P. 56 Bopd + 1440

wt. grav 38°