

Graham


KANSAS

SECTION 7 TOWNSHIP 9 RANGE 21 W

WELL NO. #1 Shaw "A"

COMPANY C & G Drlg.

NORTH

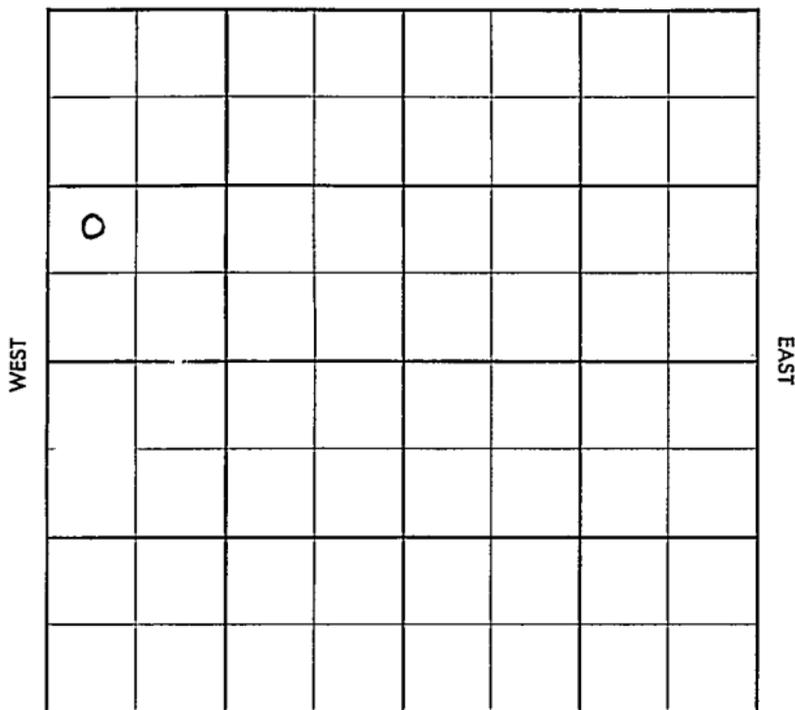

SOUTH

WEST

EAST

Graham

KANSAS

SEC.	TWP.	R.
7	9	21W

WELL NO. #1 Shaw "A" FARM

COMPANY C & G Drlg

CONTRACTOR Co Tools

Morel


_____ Ft. from N. Line

_____ Ft. from S. Line

_____ Ft. from E. Line

_____ Ft. from W. Line

NW SW NW

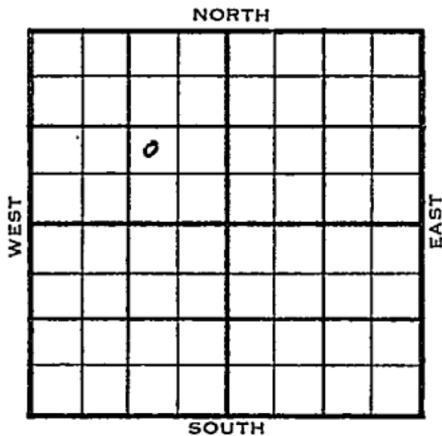

1955	ELEVATION	2271 DF	REPORT
	2271 DF	2274 RB	

11/9
Comm 11-4-55
8" @ 169/150
Drlg 2480

11-23
D & A
H. 3464
L. 3502
B.K.C. 3714
A 3838
TD 3858'

ABANDONED

County Graham Elev. 2274 RB
 Sec. 7 Twp. (9N) Rge. 21W
 Company C & G DRLG.
 FarmName Shaw "A" No. 1

TOPS	DEPTH	LOG	DATUM
Anh.			
Tp.			
H.			
Tr.			
Dg.			
Bl.			
L.			
K.C.			
B.K.C.			
Ce.			
C.			
M.			
M.			
K.			
Mz.			
Me.			
V.			
S.			
S.			
A.			
R.			
PE.			
G.			
T.B.			

Loc. in Sec. NW SW NW
 Geol. _____
 Contr. _____
 Co. tools _____
 Pool Morel
 NOV 9 '55
 FIRST REPORT

Date Comm. 11-4-55
8" @ 169/150 drlg. 2480

Co.
 Lse.
 No.
 Sec.
 T.
 R.

2277 DF

County Graham Elev. 2274 RB
 Sec. 7 Twp. 9N Rge. 21W
 Company C & G Drig.
 FarmName Shaw "A" No. 1

TOPS	DEPTH	LOG	DATUM	Loc. in Sec.												
Anh.				NW SW NW												
Tr.																
H.	<u>3464</u>		<u>1190</u>													
Dg.																
Bl.																
L.	<u>3502</u>		<u>1228</u>	Geol.												
K.C.				Contr.												
B.K.C.	<u>3714</u>		<u>1440</u>	Co. tools												
Ce.				Pool												
C.				Morel												
M.				<table border="1"> <tr><td></td><td></td><td></td></tr> <tr><td></td><td></td><td></td></tr> <tr><td></td><td></td><td></td></tr> <tr><td></td><td></td><td></td></tr> </table>												
Mz.																
Mq.																
V.																
S.																
S.																
A.	<u>3838</u>		<u>1564</u>	ABANDONED												
R.																
Pe.																
G.																
T.D.	<u>3858</u>															

Date Comm. 11-4-55 NOV 23 1955

8" @ 169/150

D & A

Co.
Lse.
No.
Sec.
T.
R.