


Section 7 Township 9 Range 21 W

Well No. # 1 Thompson

Company Peel-Hardman

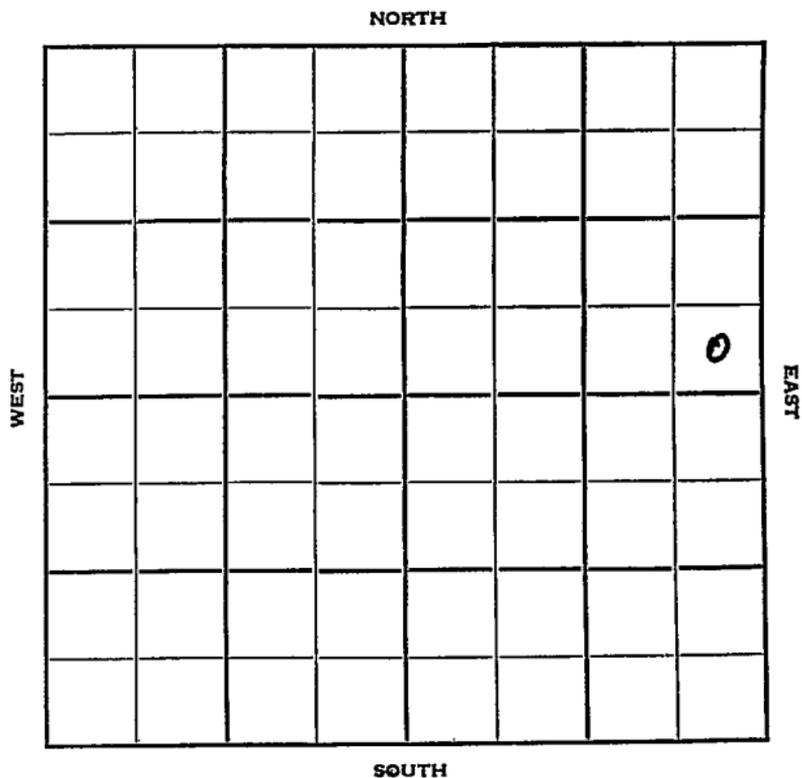

Sec. 7 Twp. 9 R. 21W

Well No. #1 Thompson Farm

Peel - Hardman Company


Peel - Hardman Contractor

_____ Ft. from N. Line

330 Ft. from S. Line

330 Ft. from E. Line

_____ Ft. from W. Line

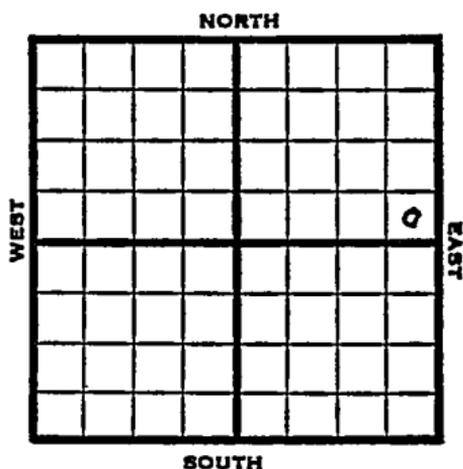

SE SE NE

1953 Elev. 2251' REPORT

6/24 Drlg 3000'

7/1 RTD 3790
5" @ 3786'

7/8 CO 3788'
300 A S/ 5 boph.

7/22 NR

7/29 "

8/5 OilWell
TD 3788
8" @ 168
Anhy 1738, Heeb 3426, L ans 3468, B KC
3680, Arb. 3783
TD 3788
5" @ 3784
CO to 3788, 300A
S/5 boph
Comp. 211 bopd

COMPLETED

