
DX 78-1

Graham Kansas

Section 7 Township 9 Range 22W

Well No. 1 Gustafson

Company C & G Drlg.

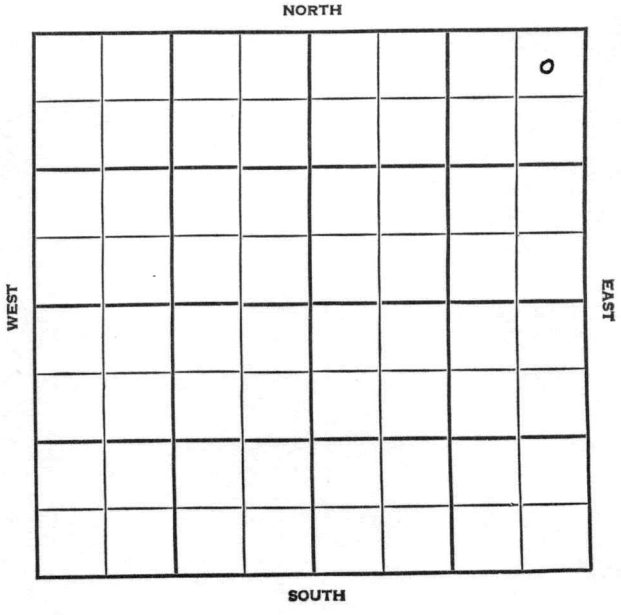

Graham KANSAS

SEC.	TWP.	R.
7	9	22W

WELL NO.

#1 Gustafson FARM

COMPANY

C & G Drlg.

CONTRACTOR

C & G Drlg.


Wildcat.

330 Ft. from N. Line

Ft. from S. Line

330 Ft. from E. Line

Ft. from W. Line

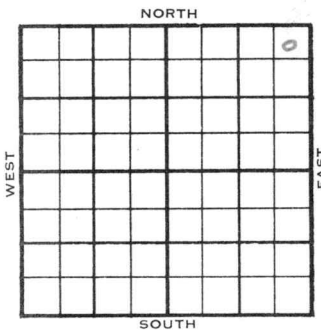

NE NE NE

Carter - DHM

1954	ELEVATION 2314'	REPORT
5/26	Location	
6/9	"	
6/23	Spud 6-8-54 D&A TD 4085' 8" @ 181' Anhy 1880', Heeb 3564', Tor 3584', KC 3603', B KC 3825', Marm. 3895', Cong. 3982', Ero Arb. 4057', Arb. 4064 TD 4085' D&A	

ABANDONED

DX-78

FORM 275 FOR SALE BY KANSAS BLUE PRINT CO.


County Graham State Kansas

Sec. 7 (Blk. Twp.) 9 (Sur. Rge.) 22W Map No.

Operator C & G Drlg.

Well No. 1 Farm Gustafson

Elev. Location NE NE NE

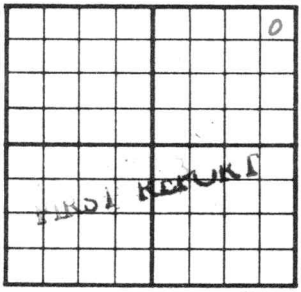

330 Ft. From N Line NE

330 Ft. From E Line Quarter

1st. Report MAY 2 6 1954

Completion

Remarks Carter - DHM

C & G Drlg. - Contr.

Spudding Date

Drlg. Data Wildcat

Location

J. G. McGEHEE

FORM 275 FOR SALE BY KANSAS BLUE PRINT CO.


County Graham State Kansas

Sec. 7 (Blk. Twp.) 9 (Sur. Rge.) 22W Map No.

Operator C & G Drlg.

Well No. 1 Farm Gustafson

Elev. 2314 Location NE NE NE

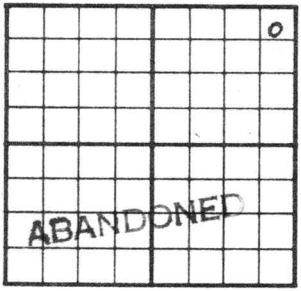

330 Ft. From N Line NE

330 Ft. From E Line Quarter

1st. Report

Completion JUN 23 1954

Remarks Wildcat

C & G Drlg. - Contr.

Spudding Date 6-8-54

Drlg. Data D & A TD 4085

8" @ 181 Anhy 1880 Heeb. 3564

Tor. 3584 KC 3603 B KC 3825

Marm. 3895 Cong. 3982 ErcArb. 4057

Arb. 4064 TD 4085

D & A

J. G. McGEHEE