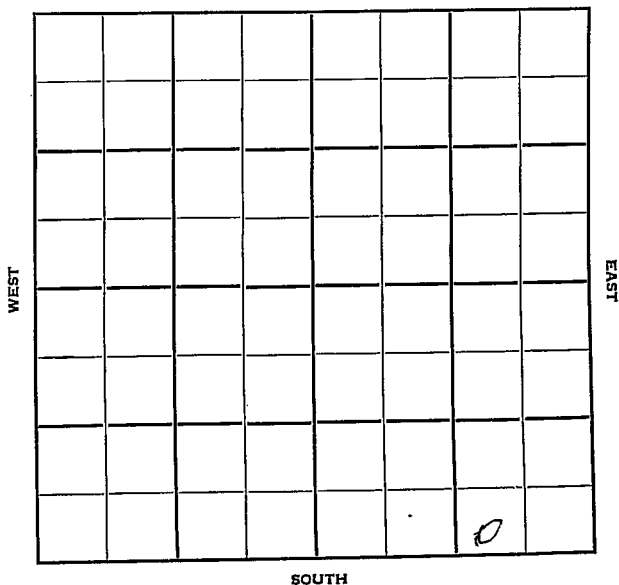


KANSAS

Dorr

Section 8 Township 9 Range 16WWell No. 1 McCarfneyCompany Ben BraekDorr
NORTH

Rooks

KANSAS

Sec. 8 Twp. 9 R. 16W ☒

Well No. #1 McCarfney Farm

Ben Brack

Company

Dorr Pool


 Ft. from N. Line

330' Ft. from S. Line

990' Ft. from E. Line

 Ft. from W. Line

SW SE SE

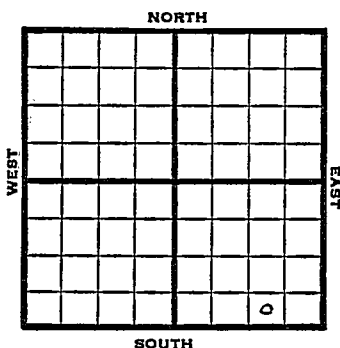

1949

Elev 1967& REPORT

6/8 Drlg. 200' *Let to Lewis*
6/15 " *8-19-49*
6/21 Lansing 3095'
Arb. 3448-75'
TD 3475'
5"@ 3400'
6/28 "
8/17 TD 3448'
Arb. 3448'
5"@ 3400'
48 shots 3095-3154
Aband. July 6, 1949
Aband.

ABANDONED

Rooks County Kansas State

Map No. Sec. 8 Twp. 9 R. 16W

Well No. 1 McCarfney

Ben Brack Company

Contractor

SW SE SE


FIRST REPORT SECTION PLAT

Ft. from N. Line

330 Ft. from S. Line

990 Ft. from E. Line

Ft. from W. Line

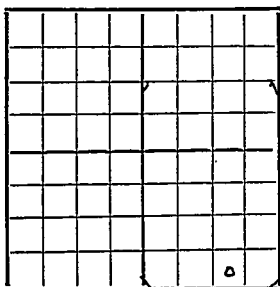

Dorr Pool

Remarks:

d $\pm$ lg. 200

Date JUN 8 1949

Scout S. J. LEWIS

Map No. K64 Sec. 8 Twp. 9 R. 16W

Well No. 1 McCarfney

Ben Brack

Company

ABANDONED

Contractor

SW SE SE


E. 1967
SECTION PLAT

 Ft. from N. Line

330 Ft. from S. Line

990 Ft. from E. Line

 Ft. from W. Line

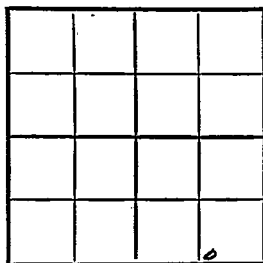

Rooks County

Location

Rig up

Drilling and Remarks:

Arb. 3448

5" @ 3400

48 shots 3095-3154

Abandoned

July 6, 1949

RECORD

Cased in., ft.

Sand

Gas

Oil

Total Depth 3445

PRODUCTION

1st 24 hrs. Nat.

1st 24 hrs. after shot

Gas Cu. Ft.

Dry Hole

Abandoned

Date

AUG 17 1949 19

S. J. LEWIS

Scout