


Section 8 Township 9 Range 17W

Well No. #1 Fisher

Company Ed Fisher

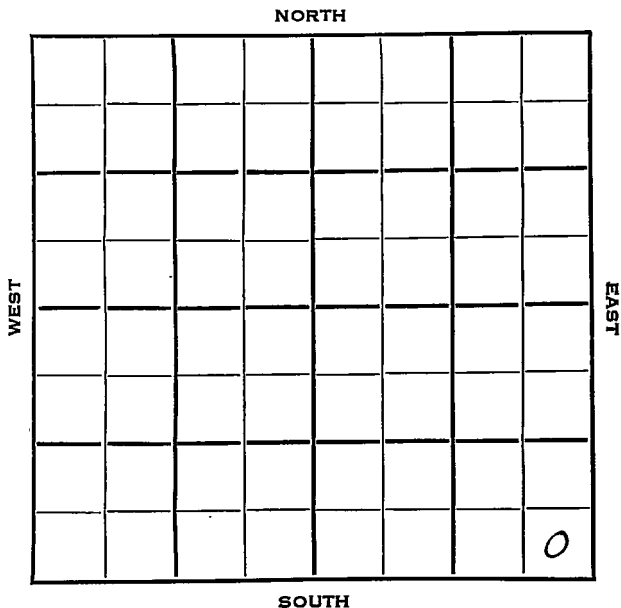

SEC. 8	TWP. 9	R. 17W ✓
-----------	-----------	-------------

WELL NO. **1 Fisher** FARM

COMPANY **Ed Fisher**


CONTRACTOR **Trans-Era
Semi Wildcat**

_____ Ft. from N. Line

330 _____ Ft. from S. Line

330 _____ Ft. from E. Line

_____ Ft. from W. Line

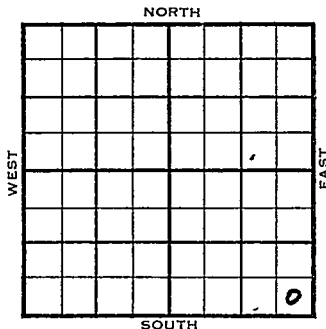

SE SE SE

1953	ELEVATION 2025'	REPORT
11/4		Spud 10-31-53 8" @ 162 Drlg. 1760'
11/11		Heeb 3145 Tor 3163 KC 3185 DST 3222-27, 1 hr, 15' M 700# 15" DST 3278-84, 1 hr, 30' SOCM Drlg. 3367'
11/18		Arb. 3464' DST 3465-70, 1 hr, 60' MCO, 60' free oil, 3' wtr. 760# RTD 3470 5" @ 3466 CO 3470 B/est 15 GOPH
12/9		NR
12/16		"
1954 2/17		Spud 10-31-53 Oil Well TD 3470' 8" @ 162' Heeb 3145', Tor 3163', KC 3185' DST 3222'-27' opn 1 hr, rec 15' Mud 700# DST 3278'-84' opn 1 hr, rec 30' socm 75# Arb 3464'

OVER

1954

Information brought forward.

2/17

DST 3465'-70' opn 1 hr, rec 60' mco
60' free oil 3' wtr, 760#
TD 3470'
5" @ 3466'
CO to 3470'
B/ 15 goph
250 A 1 boph 30% wtr. 500 A
S/ 5 boph 30% wtr.
P/ 25 bopd 5 bw
Comp 22 bopd 5 bw

COMPLETED

