

KANSAS

Rooks

8

9

18W

Sec. _____ Twp. _____ R. _____

Well No. #1 Smith Farm _____

Cities Service Company _____


Wildcat

330 Ft. from N. Line

_____ Ft. from S. Line

_____ Ft. from E. Line

330 Ft. from W. Line

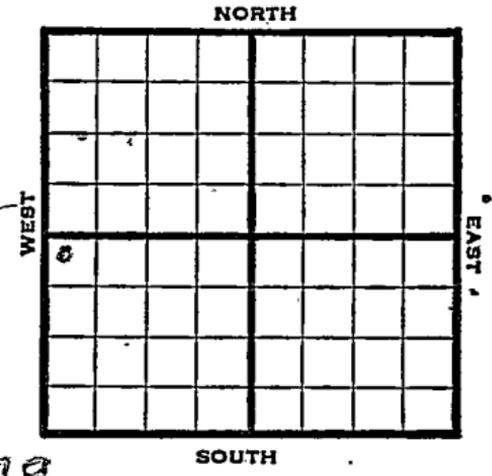

NW SW

2179

1947

Elevation ~~REPORT~~ REPORT

10/8

8" @ 240 WOC

10/15

Drlg. 3240'

10/22

Arbuckle 3522'
Total Depth 3555'

ABANDONED

$$\begin{array}{r}
 3522 \\
 2079 \\
 \hline
 1443
 \end{array}$$

Wildcat

Form 26 200 Bks. 10-46 Petrol
Kansas

Map No. _____ Sec. 8 Twp. 9 R. 18W

Well No. 1 Smith

Cities Service Company

FIRST REPORT Contractor

NW SW

SECTION PLAT

330 Ft. from N. Line

_____ Ft. from S. Line

_____ Ft. from E. Line

330 Ft. from W. Line

| | | | |
|----|--|--|--|
| | | | |
| | | | |
| 10 | | | |
| | | | |

Rooks County

Location _____

Rig up _____

Drilling and Remarks:

8" C 240 WOC

RECORD

Cased _____ in., _____ ft.

Sand _____

Gas _____

Oil _____

Total Depth _____

PRODUCTION

1st 24 hrs. Nat. _____

1st 24 hrs. after shot _____

Gas _____ Cu. Ft.

Dry Hole _____

Abandoned _____

Date

OCT 8 1947

19

S. J. LEWIS

Scout

Kansas Wildcat

Map No. 64 Sec. 8 Twp. 9 R. 18W

Well No. I Smith

Cities Service Company

ABANDONED

Contractor

NW SW

E. 2077

SECTION PLAT

330 Ft. from N. Line

_____ Ft. from S. Line

_____ Ft. from E. Line

330 Ft. from W. Line

| | | | |
|---|---|--|--|
| | | | |
| | 1 | | |
| 0 | | | |
| | | | |

Rooks County

Location _____

Rig up _____

Drilling and Remarks:

CEL 8022

RECORD

Cased _____ in., _____ ft.

Sand _____

Gas _____

Oil _____

Total Depth 2077

PRODUCTION

1st 24 hrs. Nat. _____

1st 24 hrs. after shot _____

Gas _____ Cu. Ft.

Dry Hole _____

Abandoned _____

Date

OCT 22 1947 19

S. J. LEWIS Scout