

KANSAS

Rooks


O.W.W.O.

Section 8 Township 9 Range 19WWell No. 2 ZieglerCompany Westworth & Sons et al

Chandler

NORTH

WEST

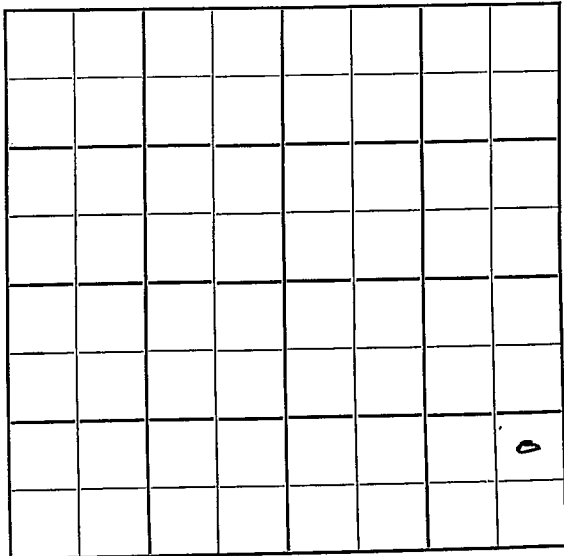

EAST

SOUTH

Rooks KANSAS ✓


Sec. 8 Twp. 9 R. 19W

Well No. #1 ² Ziegler Farm

Wentworth & Sons et al

Chandler Pool (Wentworth, Cont.) Company

NORTH

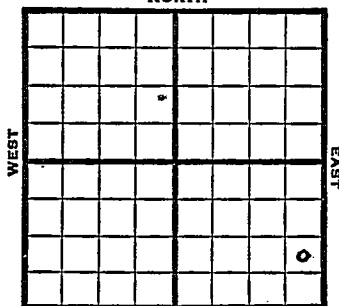

Ft. from N. Line

990'

Ft. from S. Line

330'

Ft. from E. Line

Ft. from W. Line

NE SE SE

SOUTH

1949

Elev 2062'

REPORT

8/31

Derrick

9/7

"

9/14

8" @ 150'

Lansing 3265'

Drlg 3457'

9/21

Arbuckle 3533'

TD 3537'

5" @ 3534'

9/28

TD 3559'

PB 3547'

1500 acid

Pump 2 bbls oil / 10% W PH 8 hrs.

10/5

3000 acid

Pump 5 bbls oil PH / 25% W

10/12

"

10/19

TD 3559'

Lansing 3265'

Cong 3508'

Arb. 3533'

5" @ 3534'

4500 Acid

Pump 72 Oil Pot

27° Gr.

Comp

COMPLETED

(Over)

1951

O.W.W.O.

1/10 Lans. 3265+ Arb. 3533
OTD 3559
CO to 3559
500 A S/2 $\frac{1}{2}$ bwph
To test KC

2/21 Oil well TD 3332
Lans. 3265 Arb. 3533
OTD 3559
500 A S/ 2 $\frac{1}{2}$ bwph SP 3361
S/ 130 bw 3 $\frac{1}{4}$ bo 12 hr.
17/ 3343-46 SP 3332 22/ 3305-09
1000 A S/ 29 bfpd S/ 13 bwph
3 $\frac{1}{2}$ boph
Comp. 53 bo 10 bwpd
COMPLETED

Kansas

Chandler Pool

Map No. _____ Sec. 8 _____ Twp. 9 _____ R. 19W

Well No. 1 Ziegler

Wentworth & Sons et al.

Company

Wentworth

Contractor

NE SE SE

FIRST REPORT
SECTION PLAT

_____ Ft. from N. Line

990 _____ Ft. from S. Line

330 _____ Ft. from E. Line

_____ Ft. from W. Line

Rooks County

Location _____

Rig up _____

Drilling and Remarks:

Derrick

RECORD

Cased _____ in., _____ ft.

Sand _____

Gas _____

Oil _____

Total Depth _____

PRODUCTION

1st 24 hrs. Nat. _____

1st 24 hrs. after shot _____

Gas _____ Cu. Ft.

Dry Hole _____

Abandoned _____

Date

AUG 31 1949

19

S. J. LEWIS

Scout

Map No. _____ Sec. 8 Twp. 9 R. 19W

Well No. 1 Ziegler

Wentworth & Sons etal. Company

COMPLETE

Contractor

NE SE SE

E12062
SECTION PLAT

			σ

_____ Ft. from N. Line

990 Ft. from S. Line

330 Ft. from E. Line

_____ Ft. from W. Line

Rooks County

Location _____

Rig up _____

Drilling and Remarks:

Leam 3265

Core 3588

Core 3533

5" 3534

4500 acid

Pump 72 oil 20 ft

27-2-4

RECORD

Cased _____ in., _____ ft.

Sand _____

Gas _____

Oil _____

Total Depth 3539

PRODUCTION

1st 24 hrs: Nat. _____

1st 24 hrs: after shot _____

Gas _____ Cu. Ft.

Dry Hole _____

Abandoned _____

Date

OCT 19 1949

19

S. J. LEWIS

Scout

County **Rooks** State **Kansas**

Sec. 8 (Blk. Twp.) 9 (Sur. Rge.) 19W Map No.

Operator C. Wentworth et al.

Well No. 2 Farm Ziegler

Elev.	2062	Location	NE SE SE
-------	------	----------	----------

REPORT

990 Ft. From S Line SE

330 Ft. From E Line Quarter

1st. Report JAN 10 1951

Completion


O.W.W.O.

Spudding Date _____

Drlg. Data


Lans. 3265 Arb. 3533 OTD 3559

CO to 3559 500 A S/ $2\frac{1}{2}$ bwph

to test KC

J. E. TYRA

County Rooks State Kansas
 Sec. 8 (Blk. 9 (Sur. 19W Map No.
 (Twp.) (Rge.)
 Operator C. Wentworth etal.
 Well No. 2 Farm Ziegler
 Elev. 2062 Location NE SE SE

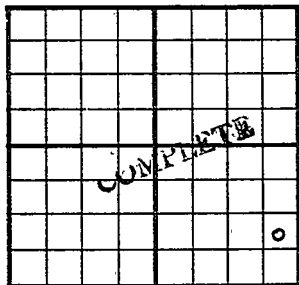

990 Ft. From S Line SE
330 Ft. From E Line Quarter
 1st. Report
 Completion FEB 21 1951
 Remarks OWWO
 Spudding Date

Drig. Data Oil well TD 3332
Lans. 3265 Arb. 3533 OYD 3559
500 A S/ $2\frac{1}{2}$ bwph SP 3361 S/ 130 bw
34 bo 12 hr. 17/ 3343-46 SP 3332
22/ 3305-09 1000 A S/ 29 bfpd
S/ 13 bwph $3\frac{1}{2}$ boph Comp. 53 bo 10 bwpd

J. E. TYRA