


Rooks

KANSAS

SECTION 8 TOWNSHIP 9S RANGE 20W

WELL NO. #1 Thyfault

COMPANY C & G Drlg. & H.G. Hansen

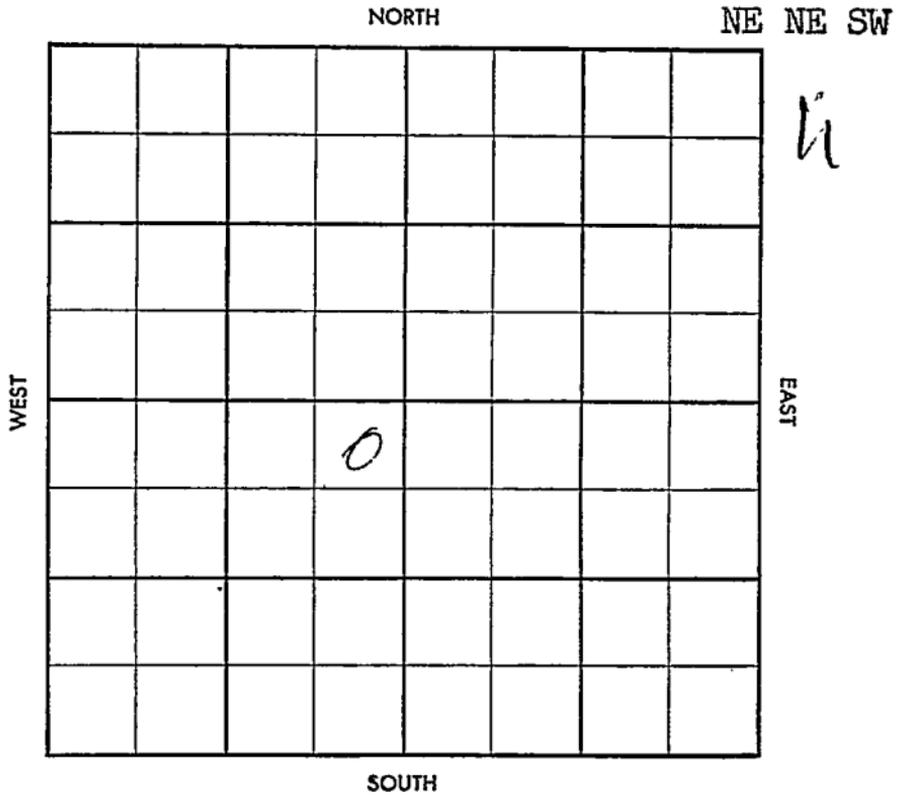

WILDCAT

813-0

FORM 513 SUNRAY

County Rooks Elev. _____
 Sec. 8 Twp. 9 Rgs. 20W
 Company G & G Drlg. & H. G. Hansen
 FarmName Thyfault No. 1

TOPS	DEPTH	LOG	DATUM
Anh.			
Tr.			
H.			
Tr.			
Dg.			
Bl.			
L.			
K.C.			
B.K.C.			
Ce.			
C.			
M.			
M.			
K.			
Mz.			
Mq.			
V.			
S.			
S.			
A.			
R.			
Pe.			
G.			
TD.			

Loc. in Sec. NE NE SW
 Geol. _____
 Contr. C & G Drlg.
 Pool Wildcat
 FIRST REPORT
 SEP 18 57

Date Comm. _____
 Location _____

Co.
 Lse.
 No.
 Sec.
 T.
 R.

County Rocks Elev. 2173 DE
 Sec. 8 Twp. 9 Rge. 20W
 Company C & G Drlg. & D. C. Hansen
 Farm Name Thyfault No. 1

TOPS	DEPTH	LOG	DATUM
Anh.	1655		
TP.		3166 3168	
H.	3374	3376 3374	
Tr.		3396	
Dg.			
Bl.			
L.	3413	3411	
K.C.			
B.K.C.		3630	
Ce.			
C.			
M.			
M.			
K.			
Mz.			
Mo.			
V.			
S.			
S.			
A	3686	3686	
R.			
PE.			
G.			
TD.	3726		

Loc. in Sec. _____ SW
 Geol. _____
 Contr. C & G Drlg.
 Pool ANPIN S
Wildcat

COMPLETE

NOV 6 '57

Date Comm. _____
 Location X Spud 9-2-57
8 5" 168/140 AAH 1655 @ 2585
0.1 2 5" DST 3571-96 30" 6' M
BHPD DST 3687-93
1 3/4 hr 20' GIP 50 OCM BHP
1062-770 DST 3693-3705
30" 15' M 50 BHP 879 DST
3705 - 15 1 hr 33' OCM
BHP 1130 - 268 DST 3715-26

1 1/2 hrs 165 GIP 100 MDG 0

40 S MDG 0 60 Clean Oil

13 HP 1100 - 983 FPO - 80

ran log 5 1/2 3714 OCT 17 57

CO 3726 TD \$ 1 1/2 BO 4 hrs

1/2 \$ 6 BO ph NW 8 hrs POP

OCT 16 57 OCT 13 57 P 33 BO NW

9 1/2 hrs WORST NOV 6 57

State test PHYP 87 BO near 24 hrs

29.10 gr

Arb ~~safe~~ open Hole

3714 - 3726