
FORM 51 25M 3-49 PETROL Graham KANSAS

Section 8 Township 9 Range 21 W

Well No. # 1 Clack "B"

Company Barnett Drlg.

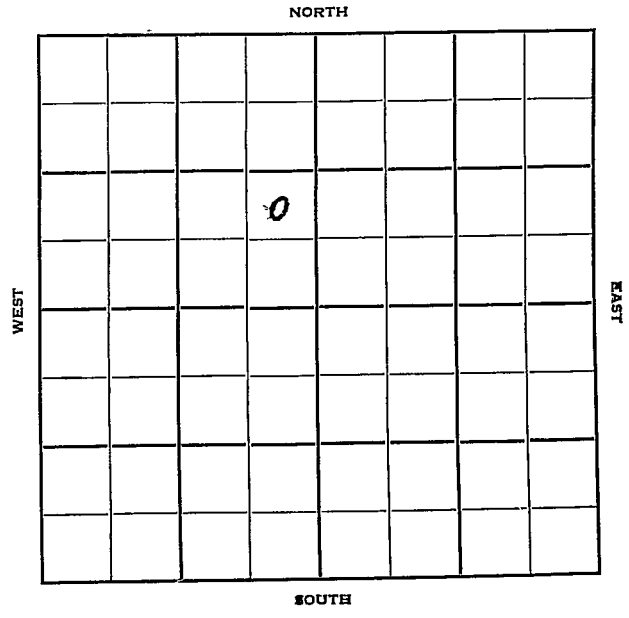

FORM 252-B

Graham KANSAS

Sec. 8 Twp. 9 R. 21W

Well No. #1 Clack "B" Farm

Barnett Drlg. Company

Contractor

Wildcat

Ft. from N. Line


990 Ft. from S. Line

330 Ft. from E. Line

Ft. from W. Line

NE SE NW

Shell Farmout &
$5000

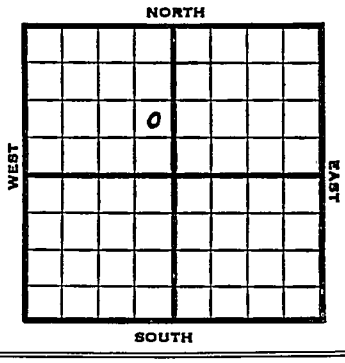

1952	Elev. 2284' REPORT
11/26	Spud 11-23-52 8" @ 120'
12/4	Drlg. 3150'
12/10	Spud 11-23-52 D & A TD 3885' 8" @ 120 Heeb 3456' Lans. 3500' B KC 3712' Cong. 3823' ReArb 3835' DST 3834-40, open ½ hr. rec 5' mud 825# Arb. 3867' TD 3885' D & A **ABANDONED**

FORM 275 FOR SALE BY KANSAS BLUE PRINT CO.


County Graham State Kansas

Sec. 8 (Blk. Twp.) 9 (Sur. Rge.) 21W Map No.

Operator Barnett Drlg.

Well No. 1 Farm Clack "B"

Elev. Location NE SE NW

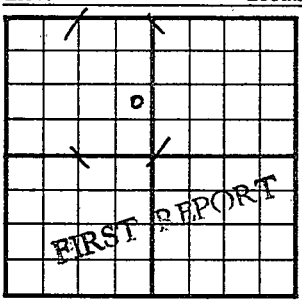

990 Ft. From S Line NW

330 Ft. From E Line Quarter

1st. Report NOV 26 1952

Completion

Remarks Shell farmout & $5000

Spudding Date 11-23-52

Drlg. Data Wildcat

8" @ 120

J. G. McGEHEE

FORM 275 FOR SALE BY KANSAS BLUE PRINT CO.


County Graham State Kansas

Sec. 8 (Blk. Twp.) 9 (Sur. Rge.) 21W Map No.

Operator Barnett Drlg.

Well No. 1 Farm Clack "B"

Elev. 2284 Location NE SE NW

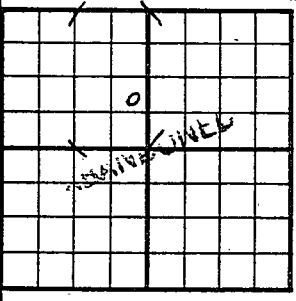

990 Ft. From S Line NW

330 Ft. From E Line Quarter

1st. Report

Completion DEC 10 1952

Remarks Wildcat

Spudding Date 11-23-52

Drlg. Data D & A TD 3885

8"@ 120 Heeb. 3456 Lans. 3500

B KC 3712 Cong. 3823 ReArb. 3835

DST 3834-40 open ½ hr. Rec. 5' mud

825# Arb. 3867 TD 3885

D & A

J. G. McGEHEE