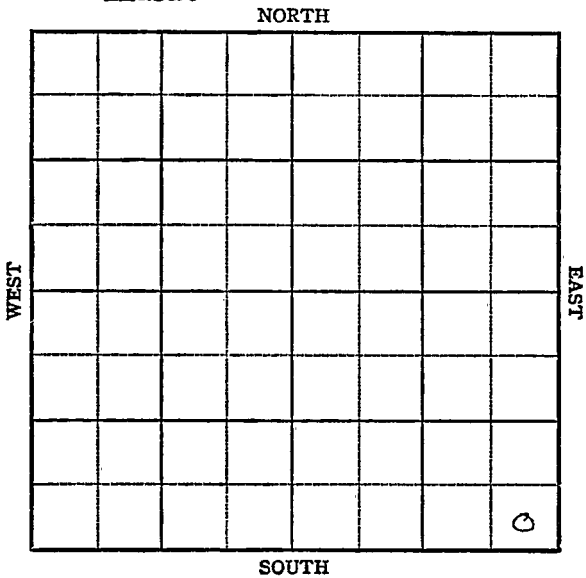


KANSAS

FORM 51 IOM 12-46 PETROL

Section 8 Township 9 Range 21-WWell No. #1 SwensonCompany Shields et al.
Wildcat

KANSAS

Graham ✓

Sec. 8 Twp. 9 R. 21W

Well No. #1 Swenson Farm

Shields et al Company

Wildcat


Ft. from N. Line

330' Ft. from S. Line

330' Ft. from E. Line

Ft. from W. Line

SE/C

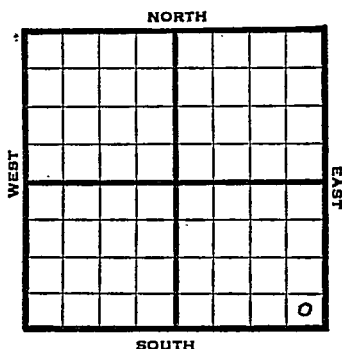

1948

Eli 2233' REPORT

7/8

8" @ 117'

Drlg. 2540'

7/8

Lansing 3875'

VSSO 3973-78'

Stains Heaby black Oil 4068-73

BKC 4129

Drlg 4150'

7/14

Lansing 3405'

Drlg 3681'

7/21

TD 3813'

Arb. 3794'

Aband.

ABANDONED

Map No. _____ Sec. 8 Twp. 9 R. 21W

Well No. 1 Swenson

Shields et al.


Company

FIRST REPORT

Contractor

SE/C

SECTION PLAT

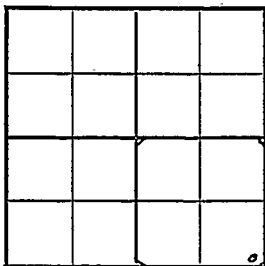

_____ Ft. from N. Line

330

_____ Ft. from S. Line

330

_____ Ft. from E. Line

_____ Ft. from W. Line

Graham County

Location _____

Rig up _____

Drilling and Remarks:

8" @ 117

drlg. 2540

RECORD

Cased _____ in., _____ ft.

Sand _____

Gas _____

Oil _____

Total Depth _____

PRODUCTION

1st 24 hrs. Nat. _____

1st 24 hrs. after shot _____

Gas _____ Cu. Ft.

Dry Hole _____

Abandoned _____

Date

JUL 8 1948 19

S. J. LEWIS Scout

Map No. 65 Sec. 8 Twp. 9 R. 21WWell No. 1 SwensonShields et al. Company**ABANDONED**

Contractor

SE/C

E/2233
SECTION PLAT Ft. from N. Line330 Ft. from S. Line330 Ft. from E. Line Ft. from W. Line

Graham CountyLocation Rig up

Drilling and Remarks:

Ac 43794

RECORD

Cased in., ft.Sand Gas Oil Total Depth 2973

PRODUCTION

1st 24 hrs. Nat. 1st 24 hrs. after shot Gas Cu. Ft.Dry Hole Abandoned

Date

JUL 21 1948 19S. J. LEWIS Scout