


Section 8 Township 9 Range 21 W

Well No. # 3 Swenson "B"

Company Barnett Oil

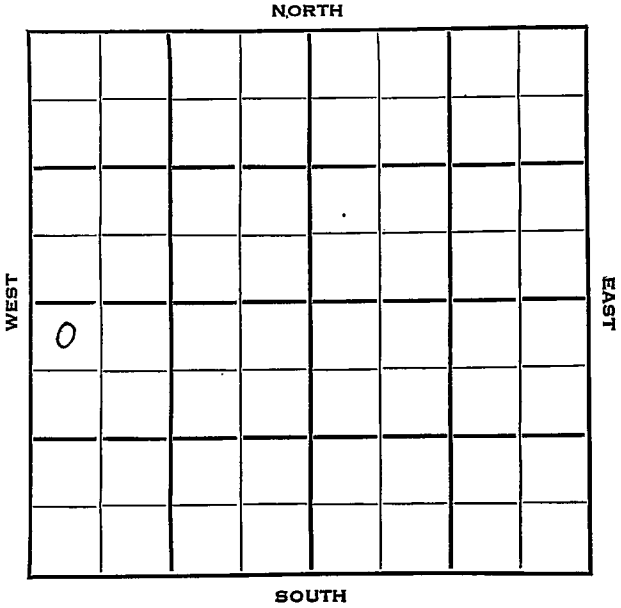

Graham

KANSAS


SEC.	TWP.	R.
8	9	21 W

WELL NO. # 3 Swenson "B" FARM

COMPANY Barnett Oil

CONTRACTOR

330 Ft. from N. Line
 _____ Ft. from S. Line
 _____ Ft. from E. Line
 330 Ft. from W. Line
 NW NW SW

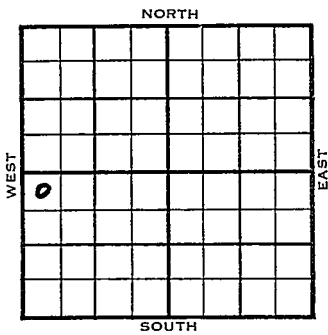

1953	ELEVATION 2295'	REPORT
------	--------------------	--------

12/2 Drilling
 1954
 1/6 Heeb 3462' Lans. 3503' Arb. 3807'
 RTD 3811' 5" @ 3805'
 1/13 CO 3811 FU 2500' oil 1 hr,
 S/23 BOPH 4 hrs.
 1/20 NR
 2/10 NR
 2/17 Spud 12-19-53
 Oil Well
 TD 3811'
 8" @ 153'
 Heeb 3462', Lans 3503' Arb 3807'
 TD 3811'
 5" @ 3805'
 CO to 3811
 FU 2500' oil 1 hr. S/ 23 boph 4 hr.
 Comp 3000 bopd.

COMPLETED

