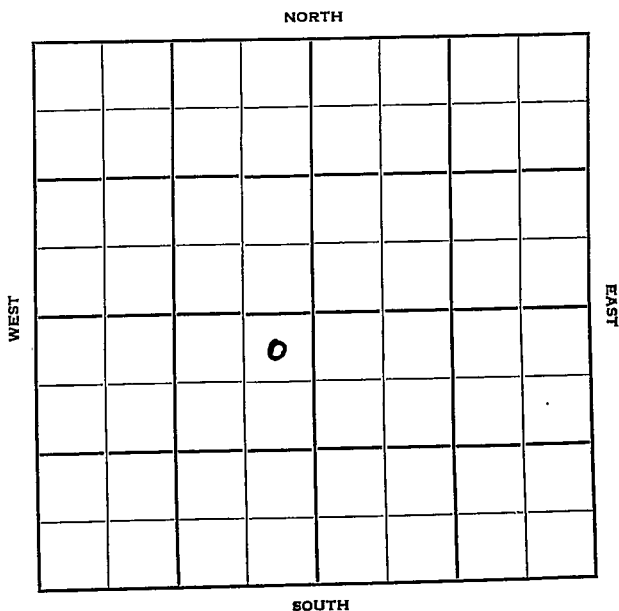


Section 8 Township 9 Range 21 WWell No. # 2 Swenson (B)Company Barnett Oil

Sec. 8 Twp. 9 R. 21W

Well No. #2 Swenson (B) Farm

Barnett Oil Company

Barnett Contractor

330 Ft. from N. Line


Ft. from S. Line

330 Ft. from E. Line

Ft. from W. Line

NE NE SW

Shell-\$3000

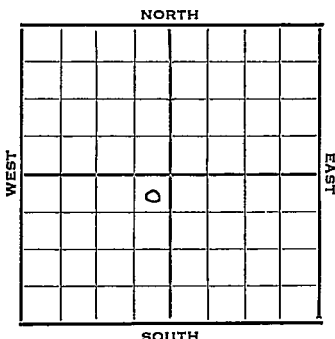

1952 Elev. 2314' REPORT

5/21 MI

5/28 8" @ 154' Anhy 1770'
Drlg. 3725'

6/11 RTD 3875 5" @ 3874 CO 3860
16/3844-48 16/3850-54
B/20 Galoph 500A

6/18 Spud 5-20-52
D&A TD 3875 8-5/8" @ 154
Anhy 1770 Heeb. 3481
Lans. 3523 B KC 3733
Cong. 3796 Arb. 3834
DST 3835-42 open 3/4 hr. rec. 22' mud
DST 3837-47 open 1/2 hr. rec. 12' mud
DST 3846-53 open 1 hr. rec. 120'
fluid 90' mco 30' vhoem
TD 3875 5" @ 3874 CO to 3860
16/3844-48 16/3850-54 B/20 goph
500 A FU 400' wtr. 1 hr.
D&A

~~COMPLETED~~

ABANDONED

County Graham State KansasSec. 8 (Blk.) 9 (Sur.) 21N Map No.Operator Barnett OilWell No. 2 Farm Swenson (B)Elev. Location NE NE SW330 Ft. From N Line SW330 Ft. From E Line Quarter1st. Report MAY 21 1952

Completion


Remarks Shell - \$ 3000.Barnett - Contr.

Spudding Date

Drlg. Data

MI

J. G. McGENEE

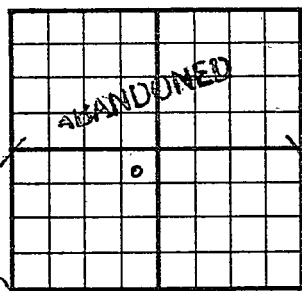County Graham State KansasSec. 8 (Blk.) 9 (Sur.) 21W Map No.Operator Barnett Oil & DerbyWell No. 2 Farm Swenson "B"Elev. 2314 Location NE NE SW330 Ft. From N Line SW330 Ft. From E Line Quarter

1st. Report

Completion JUN 18 1952

Remarks

Barnett - Contr.Spudding Date 5-20-52Drlg. Data D & A TD 38758 5/8" @ 154 Aphy 1770 Heeb. 3481Lans. 3523 B KC 3733 Cong. 3796Arb. 3834 DST 3835-42 open 3/4 hr.Rec. 22' mud DST 3837-47 open 1/2 hr.Rec. 12' mud DST 3846-53 open 1 hr.Rec. 120' fluid 90' mco 30' vhoemTD 3875 5" @ 3874 CO to 386016/ 3844-48 16/ 3850-54 B/ 20 goph500 A FU 400' water 1 hr.D & A