


Section 8 Township 9 Range 21W

Well No. 5 Swenson"B"

Company Barnett Oil, Derby Oil, R. W. Shields
& Peel-Hardman

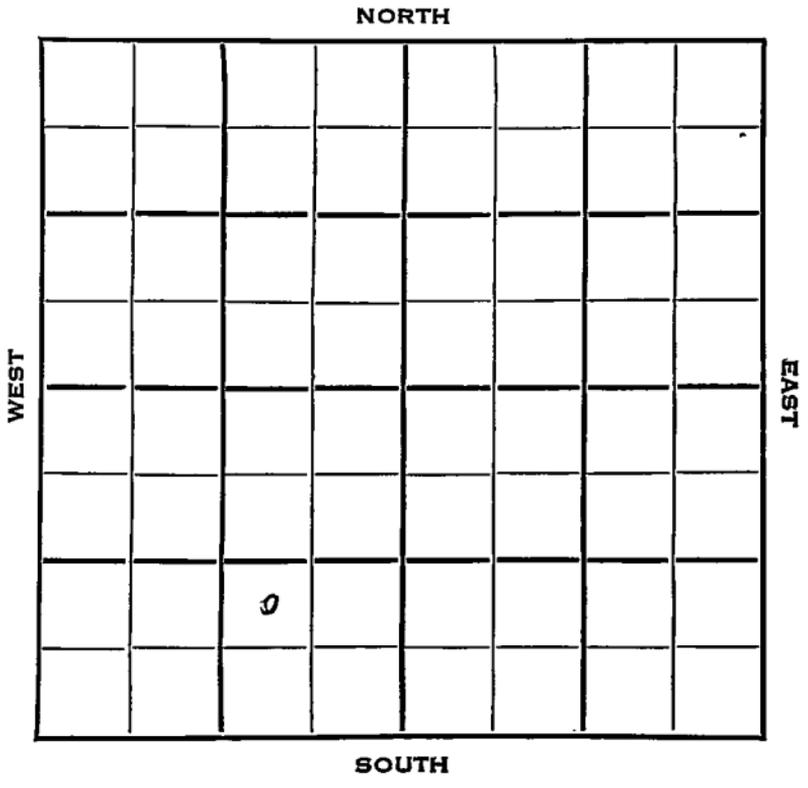

Graham

KANSAS

SEC.	8	TWP.	9	R.	21W ✓
------	---	------	---	----	-------

WELL NO.

#5 Swenson "B"

FARM

COMPANY

Barnett Oil, Derby Oil, R.W. Shields &

CONTRACTOR

Peel-Hardman

Co. Tools.

Morel Pool

_____ Ft. from N. Line


990

_____ Ft. from S. Line

990

_____ Ft. from E. Line

_____ Ft. from W. Line

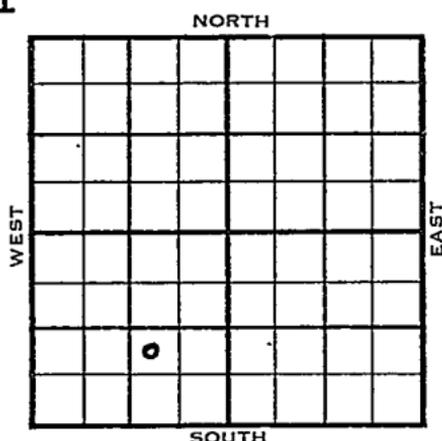

NW SE SW

	ELEVATION	REPORT
1954	2314'	

4/14

Spud 4-11-54

8" @ 157'

Drlg 300'

5/5

Spud 4-11-54

D & A

TD 3885'

8" @ 157'

Heeb 3491', Lans 3533',

TD 3885'

Cong 3864'

D & A

ABANDONED

County Graham State Kansas
 Sec. 8 (Blk.) 9 (Sur.) 21W Map No.
 Operator Barnett Oil, Derby Oil, R.W. Shields &
 Well No. 5 Farm Swenson "B" Peel-Hardman
 Elev. 2314 Location NW SE SW

FIRST REPORT

990 Ft. From S Line SW
990 Ft. From E Line Quarter
 Ist. Report APR 14 1954
 Completion _____
 Remarks _____
Co. tools
 Spudding Date 4-11-54

Drlg. Data Morel Pool
8" @ 157 drlg. 300

