

FORM 51


Rooks

KANSAS

Section 9 Township 9 Range 16W

Well No. #1 Finnesy

Company Lee Phillips

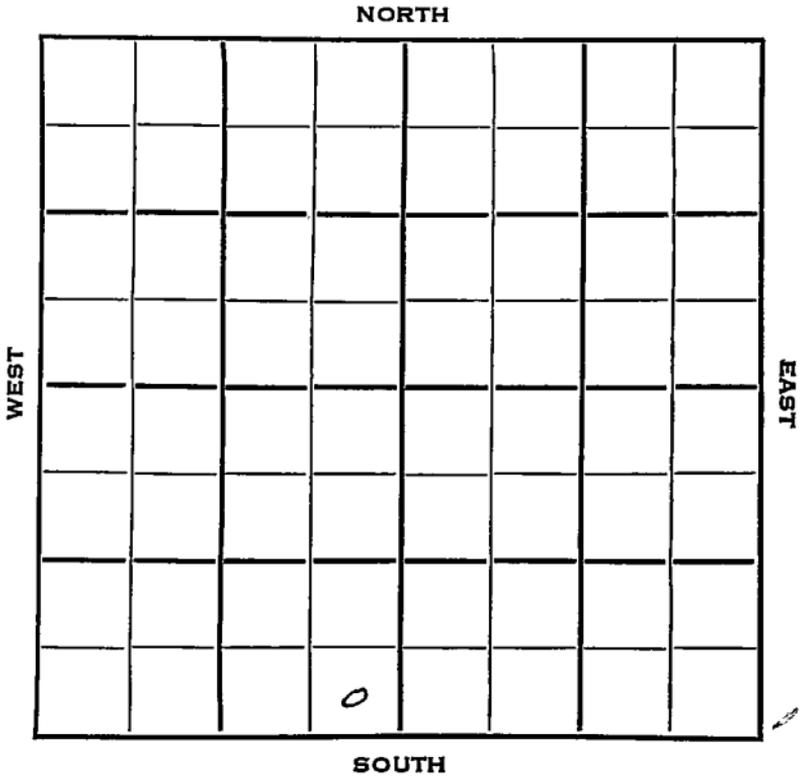



Sec. 9 Twp. 9 R. 16 W

Well No. # 1 Finnesy Farm

Lee Phillips Company

Strain Drlg. Contractor

Wildcat


\_\_\_\_\_ Ft. from N. Line

330 Ft. from S. Line

330 Ft. from E. Line

\_\_\_\_\_ Ft. from W. Line

SE SE SW

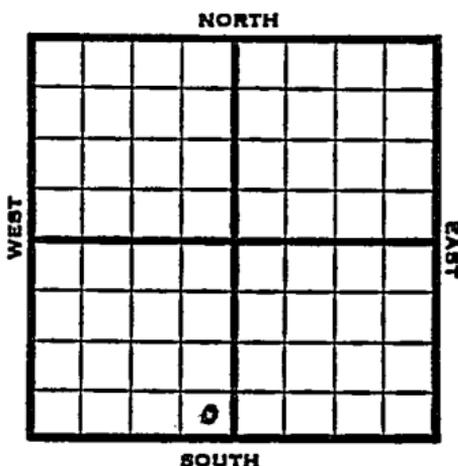

1953 Elev. 2022' REPORT

- 2/11 Spud 2-5-53  
8" @ 170 Anhy 1314  
Drlg. 2385
- 2/19 Top 2932' Heeb 3125' Tor 3146'  
Lans. 3166 B KC 3420 Cong 3481'  
Simp. 3514' Arb. 3546'  
RTD 3569'
- 2/26 D & A
- 3/11 Spud 2-5-53  
D & A TD 3569 8" @ 170  
Anhy 1314 Top 2932' Heeb 3125  
Tor. 3146 Lans 3166 B KC 3420  
Cong. 3484 Simp 3514 Arb 3546  
TD 3569 5" @ 2840 12/2661-65  
12/2724-30  
D & A

**ABANDONED**


County Rooks State Kansas

Sec. 9 (Blk. Twp.) 9 (Sur. Rge.) 16W Map No.

Operator Lee Phillips

Well No. 1 Farm Finnesy

Elev. Location SE SE SW

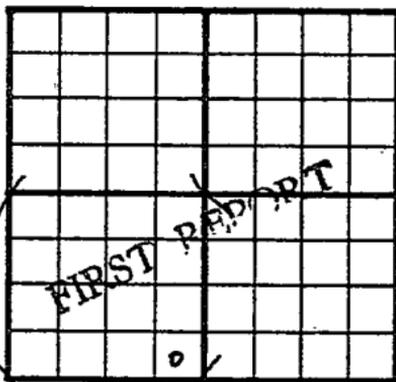

330 Ft. From S Line SW

330 Ft. From E Line Quarter

Ist. Report FEB 11 1953

Completion \_\_\_\_\_

Remarks \_\_\_\_\_


Strain Drlg. - Contr.

Spudding Date 2-5-53

Drlg. Data Wildcat

8" @ 170 Anhy 1314 drlg. 2385

County \_\_\_\_\_ Rooks \_\_\_\_\_ State Kansas  
 Sec. 9 (Blk.) 9 (Sur.) 16W Map No. \_\_\_\_\_  
 Operator Lee Phillips  
 Well No. 1 Farm Finnesy  
 Elev. 2022 Location SE SE SW

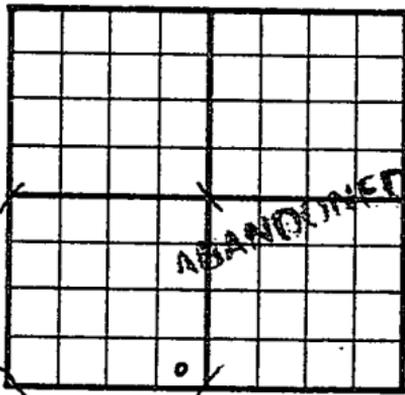

330 Ft. From S Line SW  
330 Ft. From E Line Quarter  
 Ist. Report \_\_\_\_\_  
 Completion MAR 11 1953  
 Remarks Wildcat  
Strain Drlg. - Contr.  
 Spudding Date 2-5-53

Drlg. Data D & A TD 3569

8" @ 170 Anhy 1314 Top. 2932

Heeb. 3125 Tor. 3146 Lans. 3166

B KC 3420 Cong. 3484 Simp. 3514

Arb. 3546 TD 3569 5" @ 2840

12/ 2661-65 12/ 2724-30

D & A