
Form 51—5M—4-36—Palace

Rooks

Section 9 Township 9 Range 17-W

Well Number #1 Fike

Company Graham et al

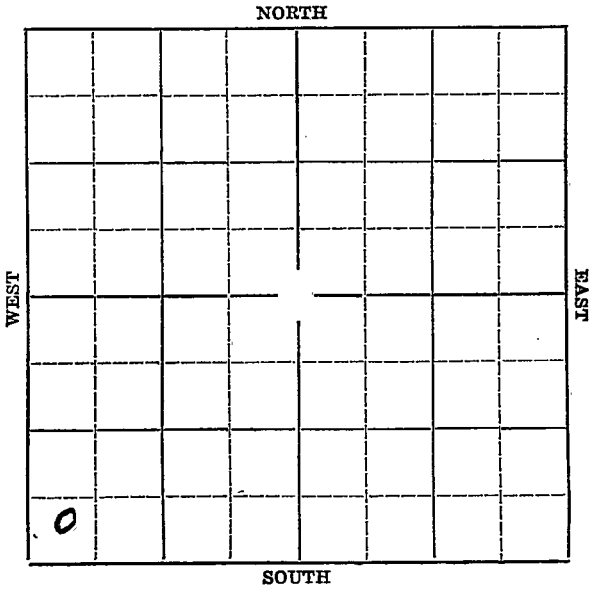


Form 252-A—5M—7-36—Palace KANSAS Rooks

Sec. 9 Twp. 9 R. 17W

Well No. #1 Fike Farm

Graham et al Company

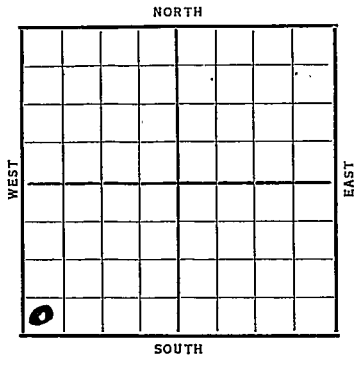

_____ Ft. from N. Line

330' Ft. from S. Line

_____ Ft. from E. Line

330' Ft. from W. Line

Elev. 2052

1936	REPORT
10/28	Rig.
11/6---11/12---	
11/19	Rig & tools
11/27	Rigging up
12/3	10" @ 150'. Anhydrate 1322'. Drlg. 1510'.
12/10	Drlg. 2680'.
12/17	Topeka 2973'. Oswald 3189'. 7" @a3205'. T. D. 3220' RUST
12/24----	
12/29	Clean out.
1937	
1/7	Show oil 3235'. T. D. 3242' Clean out.
1/14	1 Bailer oil per hour 3265'. T. D. 3296'.
1/21	Shut down 3296'.
1/28	1700' fluid in hole. Most of it water.
2/4	Run liner to 3297

1937

2/11 Swabbed 75 bbls oil, filled up 300' in 12 hrs.

2/19 5000 acid Pump 187 oil 100 water 18 hrs pumped off.

2/26 TD 3301' No test.

3/4 " " "

3/11 Shut Down

3/18 " "

3/25 " "

4/2 " "

4/8 " "

4/16 " "

4/23 " "

4/30 Fsg. 3301'.

5/7 Shut down.

5/14 " "

5/21 " "

5/28 Drlg. 3304'.
Show oil 3302-04'.

6/4 Fsg. pipe.

6/11 Drlg. 3326'.

6/19 SD 3326'.

6/25 " "

7/2 " "

7/9 " "

7/16 " "

7/23 " "

7/30 Pump 230 bbls. oil in 72 hrs.

8/6 " " " " "

8/13 " " " " "

1937

8/20 T.D. 3325'.
Testing.

8/28 " "

9/3 " "

9/10 " "

9/17 T.D. 3326' Testing.

9/24 Pump 50 oil 35 W 8 hrs.
Clean out.

10/2 T.D. 3326' Fsg.

10/8 " " "

10/15 " " "

10/22 " " "

10/29 " " "

11/5 " " "

11/12 " " "

11/19 " " "

11/26 " " "

12/3 " " "

12/10 " " "

12/17 " " "

12/24 " " "

12/31 " " "

1938

1/7 " " "

1/14 " " "

1/20 " " "

1/28 " " "

2/4 T.D. 3339' 2000' Fluid 1400' being wtr.
Cleaning out.

OVER

1938

2/11 T.D. 3358'. C.O.

2/18 SD 3370'.

2/25 " "

3/4 " "

3/11 " "

3/18 " "

3/25 " "

4/1 " "

4/8 " "

4/15 " "

4/22 " "

4/29 " "

5/6 " "

5/12 " "

5/20 " "

5/27 " "

6/3 Drlg. 3412'.

6/10 Drlg. 3471'.

6/17 Rng. 5" - 3502'

6/24 Arb. 3498'. 5" at 3498'.
T.D. 3507'. 500' water.
S.D. 0.

6/29 Arb. 3498 5" 3498
T.D. 3507 500' wtr
D & A

ABANDONED

Form 25-1M Pks.—2-29

KANSAS


Map No. 64 Sec. 9 Twp. 9 R. 17W

Well No. 1 Fike

Graham Et al. Company

Contractor

SECTION PLAT

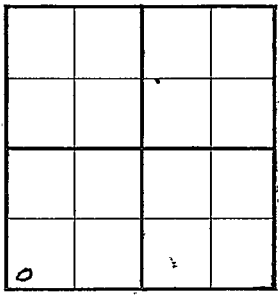

_____ Ft. from N. Line

330 Ft. from S. Line

_____ Ft. from E. Line

330 Ft. from W. Line

FIRST REPORT

Location_____

Rig up_____

Drilling and Remarks:

Rig

RECORD

Cased_____ in., _____ ft.

Sand_____

Gas_____

Oil_____

Total Depth_____

PRODUCTION

1st 24 hrs. Nat._____

1st 24 hrs. after shot_____

Gas_____ Cu. Ft.

Dry Hole_____

Abandoned_____

Date

OCT 28 1936 19

S. I. LEWIS Scout

Form 26—1M Bks.—2-29

Rooks KANSAS

Map No. 64 Sec. 9 Twp. 9 R. 17W

Well No. 1 Fike

Graham etal Company

Contractor

ABANDONED
SW/C


_____ Ft. from N. Line

330 Ft. from S. Line

_____ Ft. from E. Line

330 Ft. from W. Line

SECTION PLAT

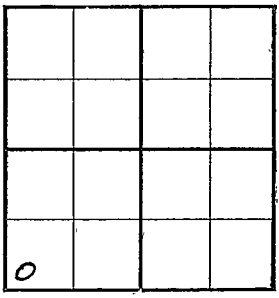

Location _____

Rig up _____

Drilling and Remarks:

500' WTR

D & A

RECORD

Cased 5 in., 3498 ft.

Sand Arb 3498

Gas _____

Oil _____

Total Depth 3507

PRODUCTION

1st 24 hrs. Nat. _____

1st 24 hrs. after shot _____

Gas _____ Cu. Ft.

Dry Hole _____

Abandoned _____

Date

JUN 29 1938 19____

H. D. Hatfield Scout