


DX 78-1

Rooks KANSAS

Section 9 Township 9 Range 17 W

Well No. # 1 Fike "B"

Company Patton & Murfin

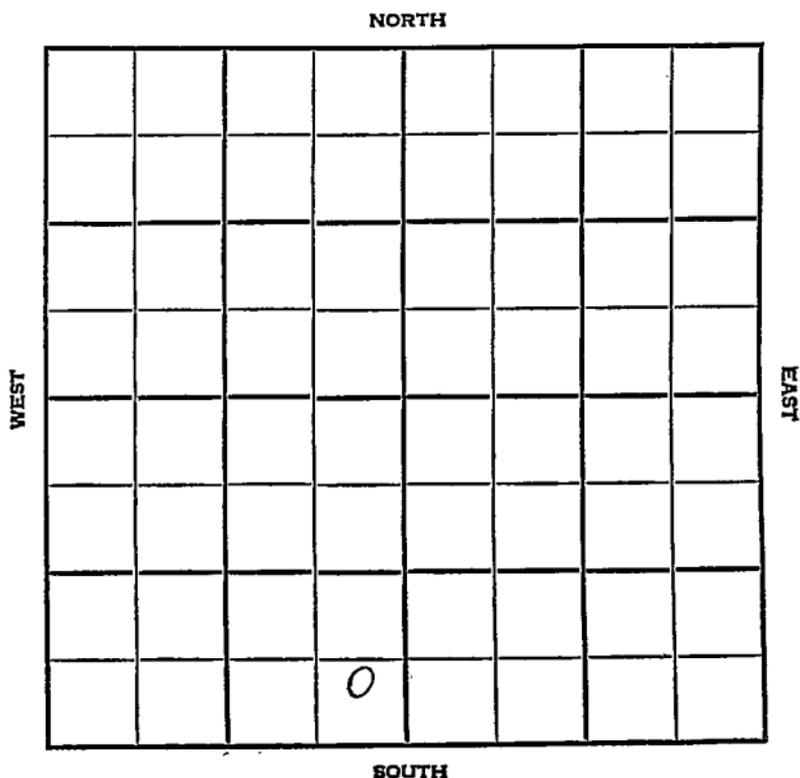

SEC.	TWP.	R.
9	9	17W

WELL NO.

#1 Fike "B"

FARM

COMPANY

Patton & Murfin

CONTRACTOR

Murfin Tools

Nyra Pool

Ft. from N. Line

NORTH


520

Ft. from S. Line

330

Ft. from E. Line

Ft. from W. Line

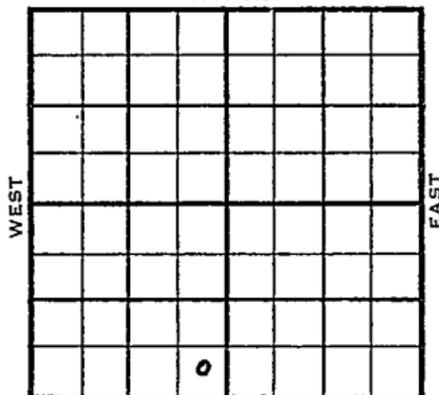

SE SE SW (Twin)

ELEVATION

REPORT

1954

2055'

9/15

Spud 9-9-54
 8" @ 182' w/125 sks
 Anhy 1354'
 Drlg. 2040'

12/15

Spud 9-9-54
 Oil Well
 TD 3489'
 8" @ 182'
 Anhy 1354', Heeb 3165' Lans 3207'
 DST 3250'-89' opn 1½ hr, rec 70' gassy
 mud, 750#
 DST 3292'-3310' opn 1 hr, rec 710'
 S.W. 800#
 DST 3386'-92' opn 50 min, rec 3' Mud
 500#
 DST 3397'-3443' opn 20 min, rec 15'
 Mud, 390# Arb. 3482'
 TD 3486'
 5" @ 3482'
 DD 3489'
 CO to 3489'
 FU 5 go 12 hr. 2000 A 2 boph 3 hr.
 SP CO to 3486 2000 A HFW 16/ 3430-
 34 1500 A S/ 2 boph
 Comp 25 bopd. 6% WPT.

COMPLETED

