


Rooks KANSAS

Section 9 Township 9 Range 17-w

Well Number 1 *Mainquist*

Company Phillips

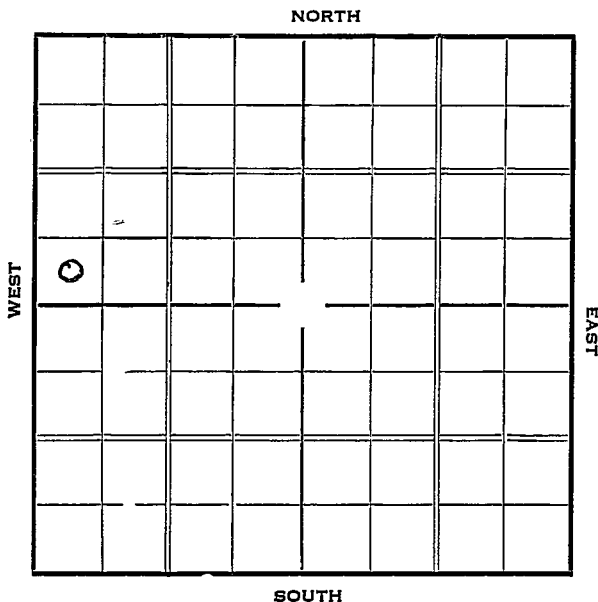

Rooks
KANSAS

Form 252-A—5M—7-36—Palace

Sec. 9 Twp. 9 R. 17-W

Well No. 1 Mainquist Farm

Phillips Company


_____ Ft. from N. Line

330 Ft. from S. Line

_____ Ft. from E. Line

330 Ft. from W. Line

Elev. 2040

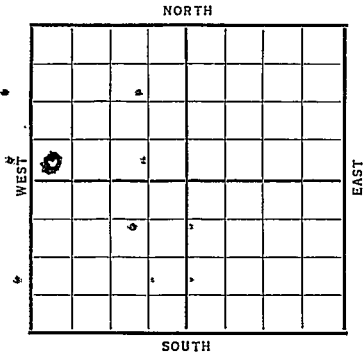

Date 1937	REPORT
1/6	Rig
1/14	"
1/21	"
1/28	"
2/4	"
2/11	"
2/19	"
2/26	Rigging up.
3/4	" "
3/11	Shut Down
3/18	" "
3/25	Drlg. 400'.
4/2	Drlg. 1100'.
4/8	12" @ 1006' W.O.C.
4/16	Anhydrate 1348' Drlg. 1880'
4/23	Fishing 2290'.
4/30	Drlg. 2680'.
5/7	Topeka 2965'. Drlg. 3195'.
5/14	K.C. 3208'. 8" @ 3229'.
	T.D. 3233'. RUST.
	OVER

1937

5/21 Drlg. 3240'.

5/28 Drlg. 3296'.

6/4 S. O. & W 3296-3300'.

T.D. 3338'. Cementing cave

6/11 " " " " "

6/19 " " " " "

6/25 Drlg. 3414'.

7/2 Sil. 3504'. T.D. 3515'.

10 BW per hr. SDO

7/7 Sil. 3504'.

T.D. 3515'.

ABANDONED

ABANDONED

ABANDONED

KANSAS

Map No. 64 Sec. 9 Twp. 9 R. 17W

Well No. 1 Mainquist

Phillips Company

Contractor

SECTION PLAT

0			

_____ Ft. from N. Line

330 Ft. from S. Line

_____ Ft. from E. Line

330 Ft. from W. Line

FIRST REPORT

Location _____

Rig up _____

Drilling and Remarks:

Rig

RECORD

Cased _____ in., _____ ft.

Sand _____

Gas _____

Oil _____

Total Depth _____

PRODUCTION

1st 24 hrs. Nat. _____

1st 24 hrs. after shot _____

Gas _____ Cu. Ft.

Dry Hole _____

Abandoned _____

Date

JAN 6 1937

S. J. LEWIS Scout

Rooks KANSAS

Map No. 64 Sec. 9 Twp. 9 R. 17^W

Well No. 1- Mainquist

Phillips Company

Contractor

ABANDONED

SECTION PLAT

0			

_____ Ft. from N. Line

330 Ft. from S. Line

_____ Ft. from E. Line

330 Ft. from W. Line

Location _____

Rig up _____

Drilling and Remarks:

D & A

RECORD

Cased _____ in., _____ ft.

Sand 511 3504

Gas _____

Oil _____

Total Depth 3515

PRODUCTION

1st 24 hrs. Nat. _____

1st 24 hrs. after shot _____

Gas _____ Cu. Ft.

Dry Hole _____

Abandoned _____

Date

JUL 7 1937 19

H. D. Hatfield Scout