


Rooks

KANSAS

SECTION 9 TOWNSHIP 9S RANGE 17W

WELL NO. #1 Mainquist "B"

COMPANY Osage O&G

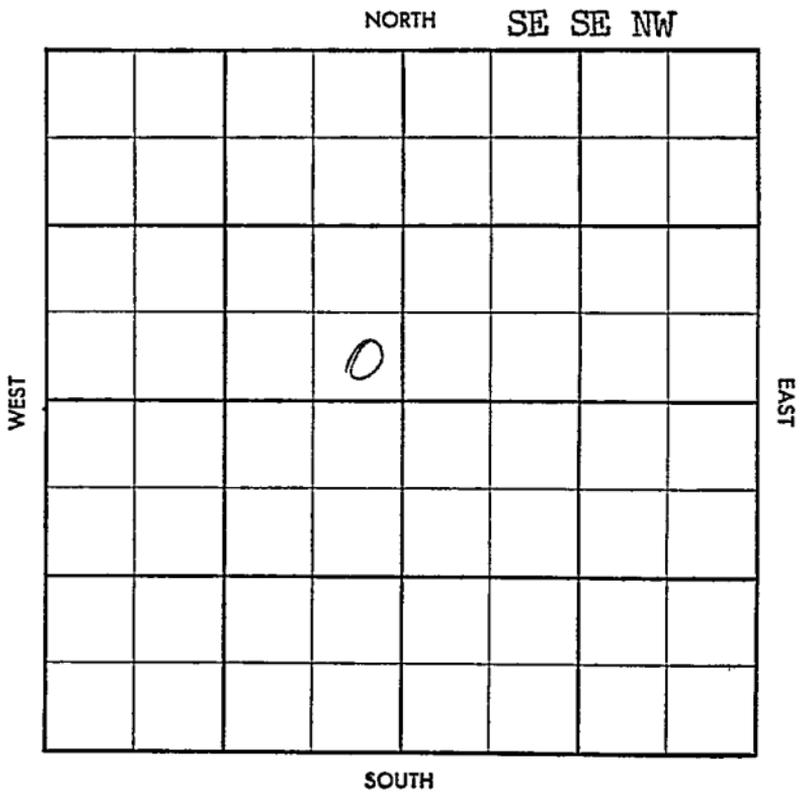



Dapita & SEL Dapita

CO. Rooks ELEV. 2057  
SEC. 9 TWP. 9 RGE. 17W  
COMPANY Osage O & G NO. 1  
2?

OCT 9 '57

ABANDONED

FARM Mainquist "B"

LOC. SE SE NW

<u>Amh 1360</u>
<u>TR 2945</u>
<u>Hb 3162</u>
<u>TR 3184</u>
<u>Lsg 3203</u>
<u>A 3483</u>
<u>TD 3520</u>

GEOL. \_\_\_\_\_  
 CONTR. \_\_\_\_\_  
 POOL Nyra  
 SPUD 9-23-57  
8" @ 182/125 WOC  
 OCT 2 '57 DST 3168-3246  
1hr 145' V HGC 650  
CM BHP 1031-883/30  
DST 3230-541hr  
200 M SW 30' M SW

SOC BHP 1098 -

995 @ 3372 OCT 9 '57 DST 3436-  
47 1hr 17' OSOKM FP 7-18  
BHP 579/30" STPK DST  
3419-3530" 33' HOCM BHP  
920/30" DST 3481-92 60"  
14" OSOKM BHP 169/30"  
DST 3492-3500 45" 22' V  
SOCM FP 12-18 BHP 758/45"  
DST 3500-20 1hr 1984' SW

FP 254-877 BHP 1054/30  
DST 3481-88 60" 12' M FP 7-18  
BHP 579/30

D of A

CO. SEC. TWP. RGE.