

Rooks


KANSAS

SECTION 9 TOWNSHIP 9 RANGE 17W

WELL NO. #4 Thompson

COMPANY Alkay Oil

NORTH

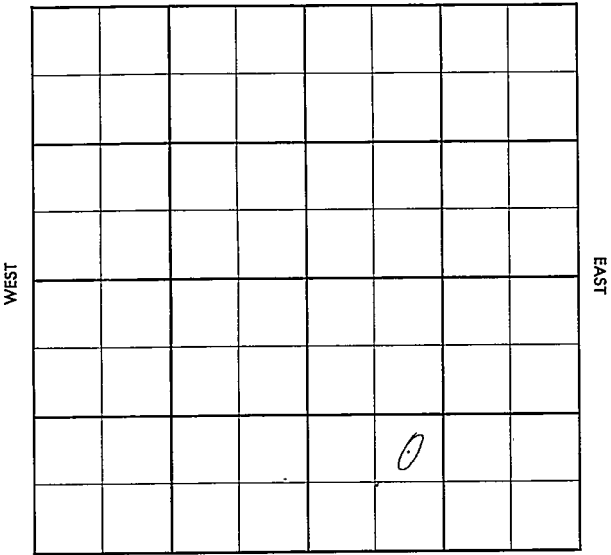

SOUTH

County Rock Elev. 2074
 Sec. 9 Twp. 9 Rge. 17W
 Company Alloy Oil
 Farm Name Thompson No. 1

TOPS	DEPTH	LOG	DATUM
------	-------	-----	-------

Anh.	1360		
Tp.			
H.			
Tr.			
Dg.			
Bl.			
L.			
K.C.			
B.K.C.			
Ce.			
C.			
M.			
M.			
K.			
Mz.			
Mo.			
V.			
S.			
S.			
A.			
R.			
PE.			
G.			
TD.			

Loc. in Sec.

NE SW SE

Geol.

Contr.

Smith & Wood

Pool DopitaNyca 1

FIRST REPORT

JAN 16 57

Date Comm. 1-9-57

8" @ 108/165 drlg. 2550



County Books Elev 2071
 Sec. 9 Twp. 9 Rge. 17W
 Company Alley Oil
 Farm Name Thompson No. 1

TOPS	DEPTH.	LOG	DATUM	Loc. in Sec.
Anh.	1360	1362		NE SW SE
TP.		2957		
H.	3180	3177		
Tr.	3203	3200		
Dg.				
BL				
L.	3222	3219		Geol.
K.C.				Contr.
BKC.				Smith & Wood
Ce.				Pool Dapita
C.				Nyra
M.				
M.				
K.				
Mz.				
Ma.				
V.				
S.				
S.	3495	3492		COMPLETE
A.				FEB 20 '57
R.				0
PE.				
G.				
TD.	3499			

Date Comm. 1-9-57

Bu @ 198/165 drlg. 2550 JAN 23 '57

DST 3211-35 1 hr 45' HOCM BHP
 170/20 DST 3239-65 1 hr
 10' MD BHP RF5/20 DST 3305
 -25 1 hr 1350' SW BHP 995/30
 DST 3408-28 1 hr 20' USOCM
 BHP 260/30" DST 3485-99 1 hr
 20' HOCM + 55' Free oil 945/30"
 Rng 5/2 @ 3496 JAN 30 '57 ✓ FEB 6 '57

00 3499 $\frac{1}{2}$ D 85 D0 in
 24 hrs To POP FEB 13 57 FEB 20 57 P.
 25 Bard 590 WTr.