

KANSAS


FORM 51 5M 6-46 PETROL

Rooks county

Section 9 Township 9 Range 17-W

Well No. #1, Fike

Company Alkay Oil Company

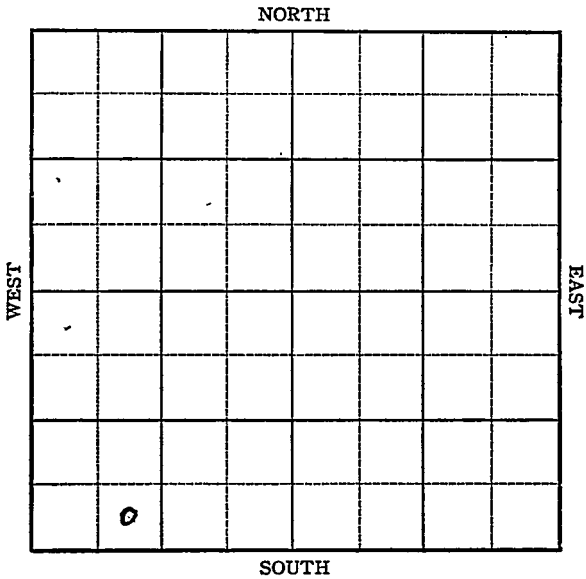

KANSAS

Rooks County

Sec. 9 Twp. 9 R. 17W

Well No. #1 Fike Farm

Alkay Oil Company

Barry


 Ft. from N. Line

330 Ft. from S. Line

 Ft. from E. Line

990 Ft. from W. Line

SE SW SW

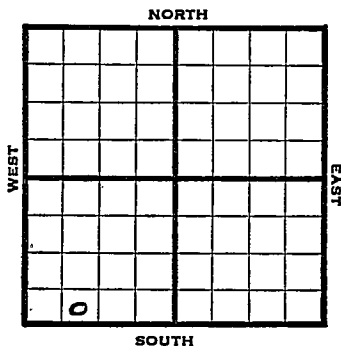

1946

2064

REPORT

9/18	Location
9/24	"
10/1	"
10/8	"
10/12	"
10/22	"
10/29	"
11/6	"
11/12	"
11/20	"
11/27	"
12/3	"
12/10	"
12/17	"

1947

1/4	Location
1/8	"
1/15	"
1/21	"

1/29 Location

ABANDONED

KANSAS

Kansas

Pool Name BarryMap No. 104 Sec. 9 Twp. 9 R. 17WWell No. 1 FikeAlkay Oil


Company

FIRST REPORT

Contractor

SE SW SW

SECTION PLAT

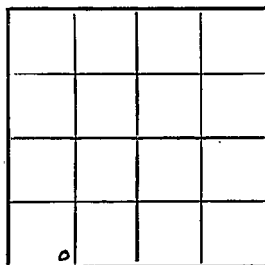 Ft. from N. Line330 Ft. from S. Line Ft. from E. Line990 Ft. from W. LineRooks CountyLocation XRig up

Drilling and Remarks:

RECORD

Cased in., ft.Sand Gas Oil Total Depth

PRODUCTION

1st 24 hrs. Nat. 1st 24 hrs. after shot Gas Cu. Ft.Dry Hole Abandoned

Date

SEP 18 1946

19

S. J. LEWIS

Scout

Map No. 64 Sec. 9 Twp. 9 R. 17W

Well No. 1 Fike

Alkay Oil Company


ABANDONED

Contractor

SE SW SW

Fl. 2064

SECTION PLAT

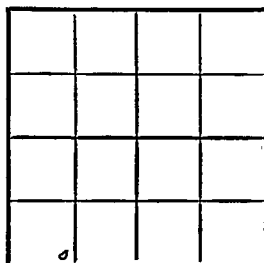

 Ft. from N. Line

330 Ft. from S. Line

 Ft. from E. Line

990 Ft. from W. Line

Rooks County

Location ✓

Rig up

Drilling and Remarks:

1

RECORD

Cased in., ft.

Sand

Gas

Oil

Total Depth

PRODUCTION

1st 24 hrs. Nat.

1st 24 hrs. after shot

Gas Cu. Ft.

Dry Hole

Abandoned Loc

Date

JAN 29 1947 19 S. J. LEWIS Scout